


T. 10 S. R. 1 E. W. M.

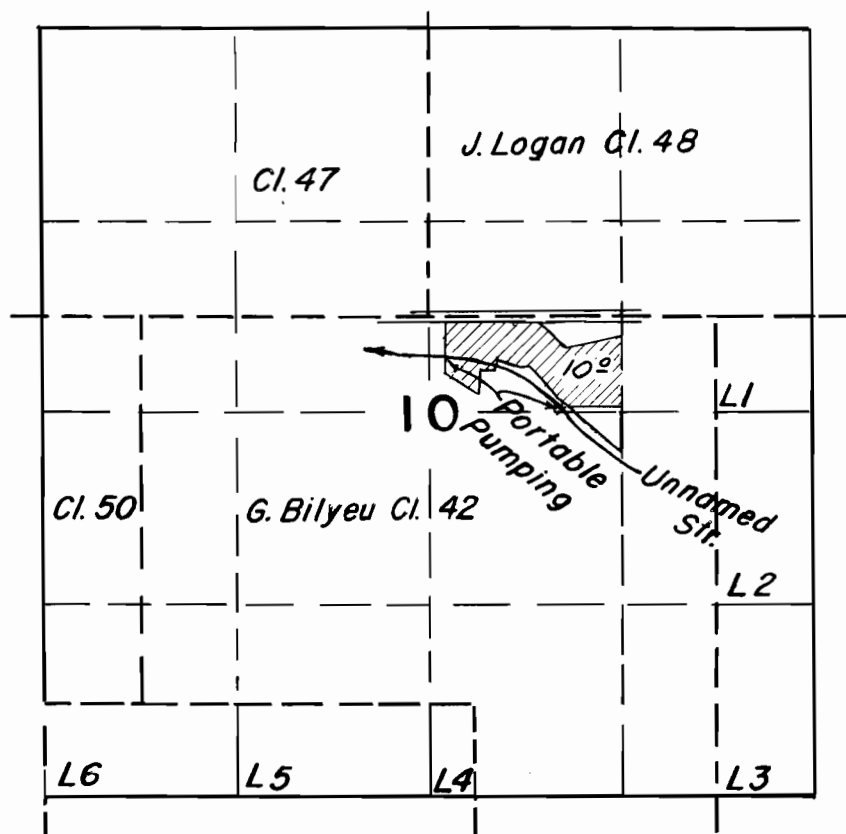

FINAL PROOF SURVEY
UNDER

Application No. 38769 Permit No. 28845
IN NAME OF

Ted J. Silbernagel

Surveyed June 2 1965, by F. Siegmund