


T. 4 S. R. 2 W. W. M.

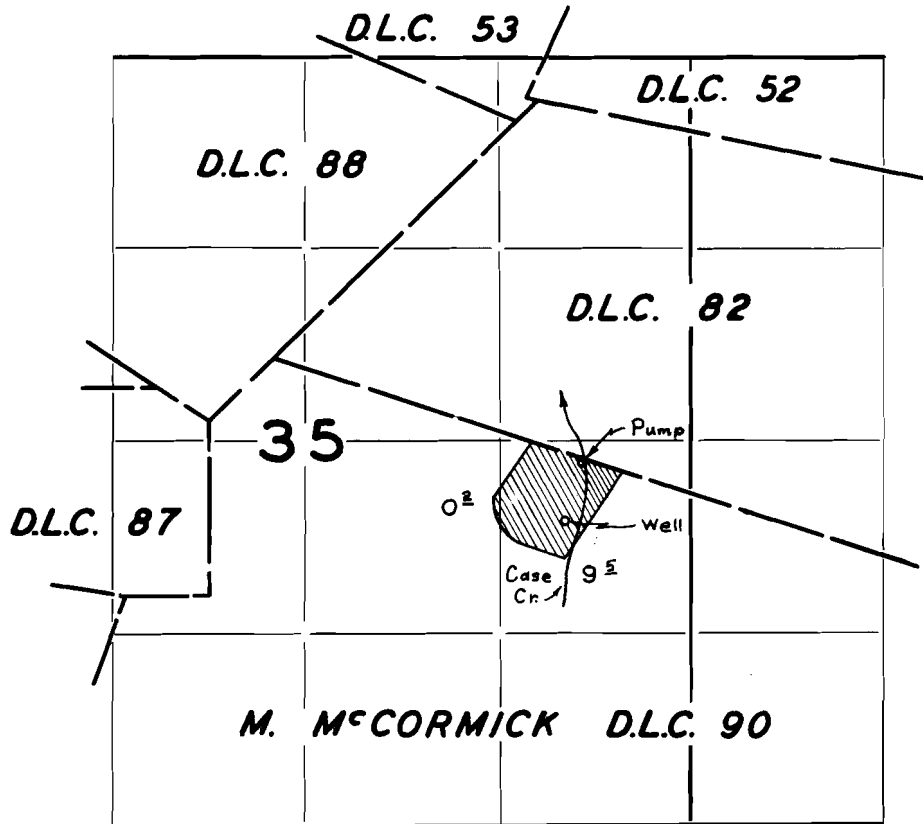

**FINAL PROOF SURVEY**  
UNDER

Application No. G-2121 Permit No. G-1963  
IN NAME OF

**HENRY BECKER**

Surveyed APR. 6 1964, by R. JACKSON