


T.8S. R.3W. W.M.

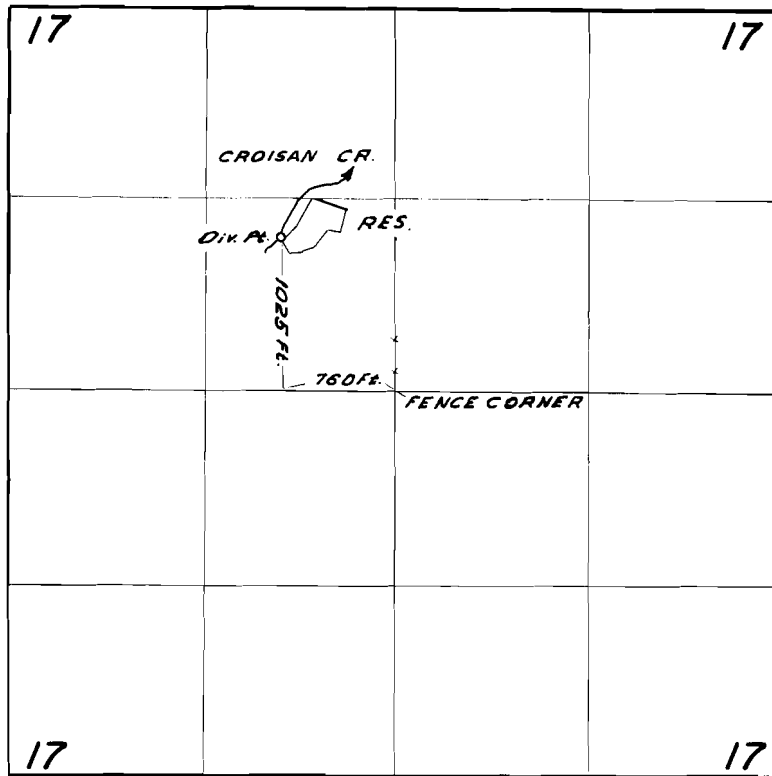

FINAL PROOF SURVEY
UNDER

Application No. R-39804 Permit No. R-4131
IN NAME OF

CAPITAL CITY TRANSFER CO.

Surveyed JUNE 18 1965, by L. COLEBANK