


T. 7 S. R. 1 E. W. M.

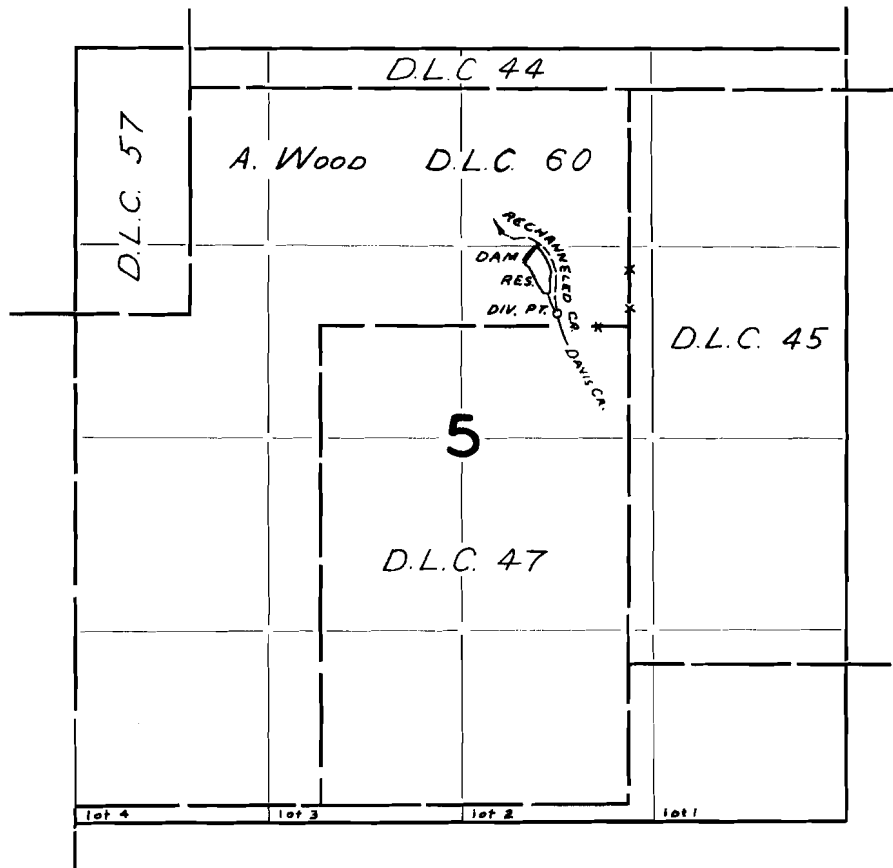

FINAL PROOF SURVEY
UNDER

Application No. ^{R-33368} 33369 Permit No. ^{R-2289} 26412
IN NAME OF

EDWARD J. FISCHER

Surveyed JUL 15 1964, by R. JACKSON