


T. 4 S. R. 1 W. W. M.

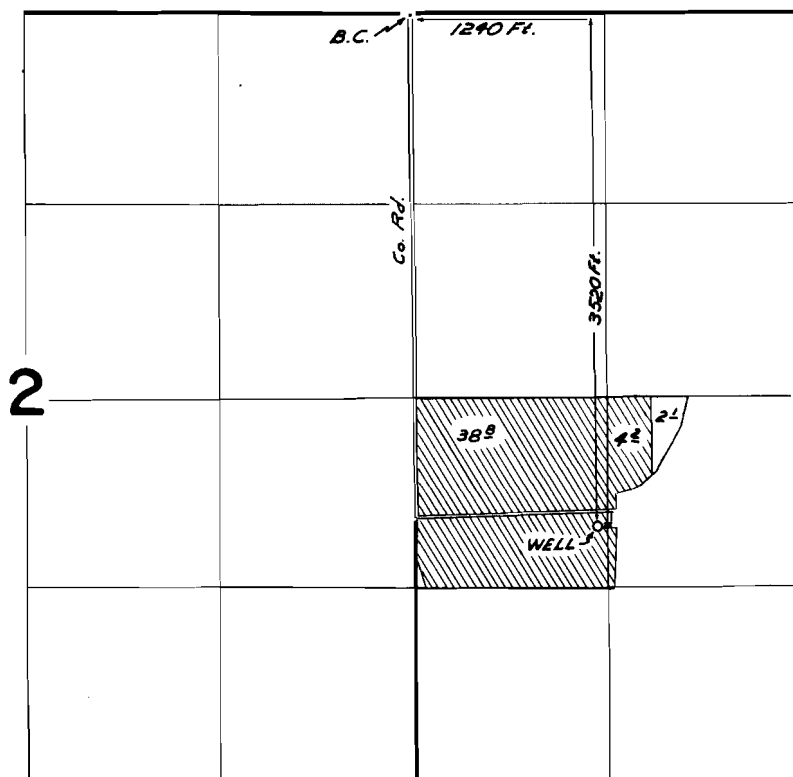

FINAL PROOF SURVEY
UNDER

Application No. **G-2869** Permit No. **G-2666**
IN NAME OF

ARCHIE HESS

Surveyed **OCT. 19, 1965**, by **L. COLEBANK**