


T. 4 S. R. 1 W. W. M.

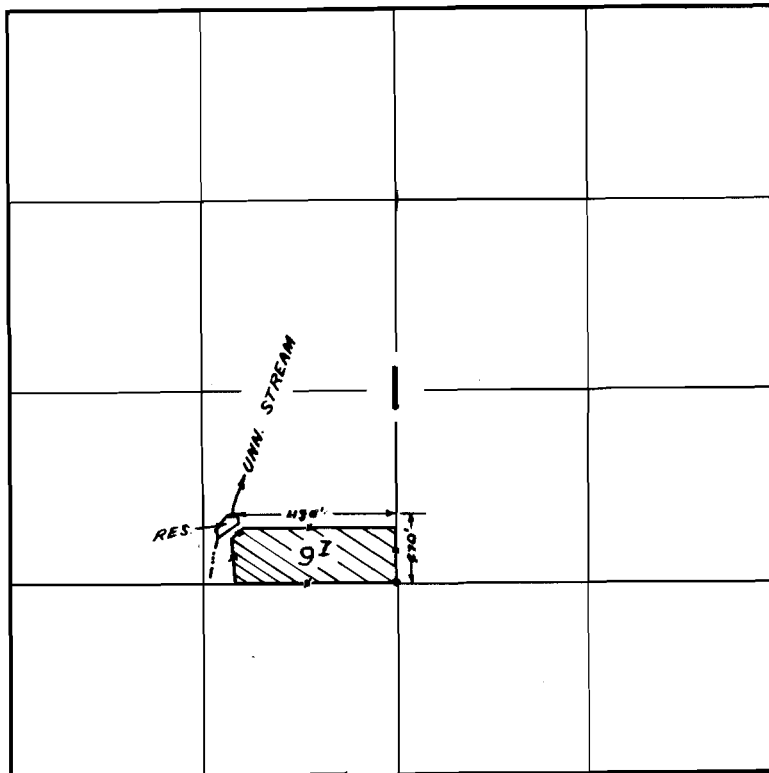

FINAL PROOF SURVEY
UNDER

Application No. R-34518 Permit No. R-2575
34519 27110
IN NAME OF

ARCHIE HESS

Surveyed APR. 12 1965, by C. GARDNER