T. 9 S. R. 3 E. W. M.

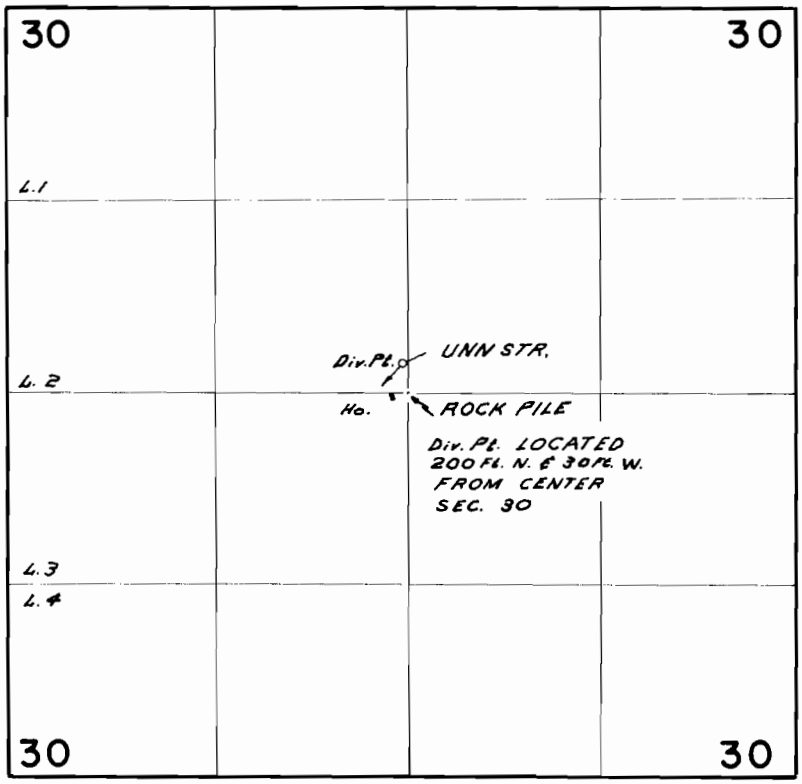

FINAL PROOF SURVEY
UNDER

Application No. 38006 Permit No. 28330
IN NAME OF

JAMES & SHIRLEY M. HOOVER

Surveyed OCT 21 1965, by L. COLEBANK

1965 U S.R.