


T.6S.R.1E.W.M.

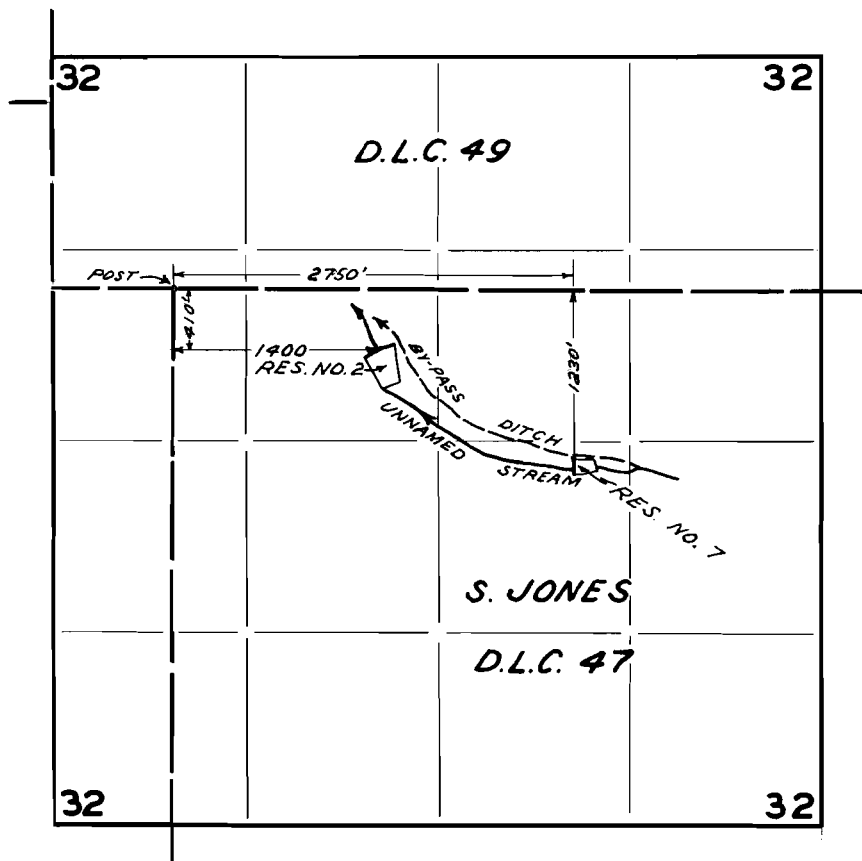

FINAL PROOF SURVEY
UNDER

Application No. R-34635 34636 Permit No. R-2714 27781
IN NAME OF

ESTATE OF OSCAR LOE

Surveyed OCT 21 1965, by L. COLEBANK