


T. 7 S. R. 2 W. W. M.

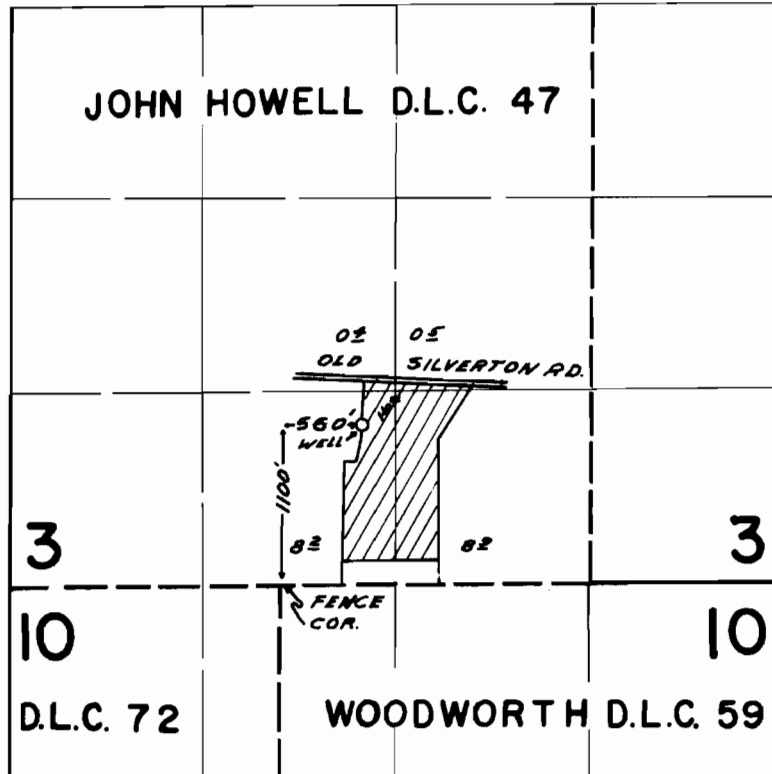

FINAL PROOF SURVEY
UNDER

Application No. G-2306 Permit No. G-2126
IN NAME OF

.....LEONARD W. ROTH.....

Surveyed APR. 13 1965, by L. COLEBANK