


T.7S. R.2W. W.M

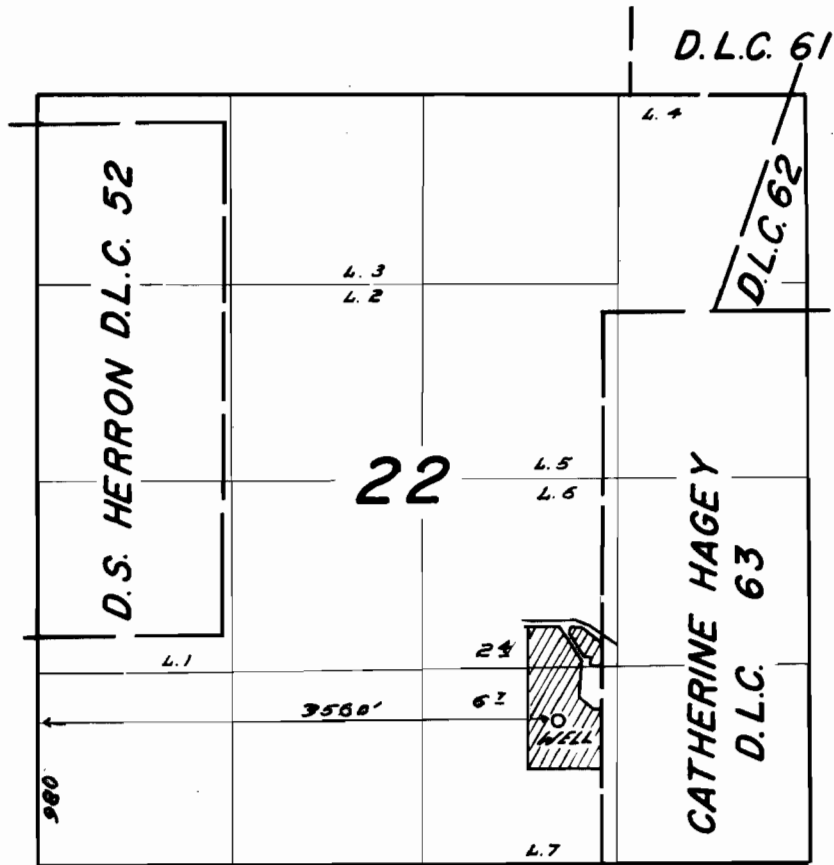

FINAL PROOF SURVEY
UNDER

Application No. 6-2202 Permit No. 6-2025
IN NAME OF

KENNETH STENSLAND

Surveyed APR. 12 1965, by L. COLEBANK