


T. 8 S. R. 4 W. W.M.

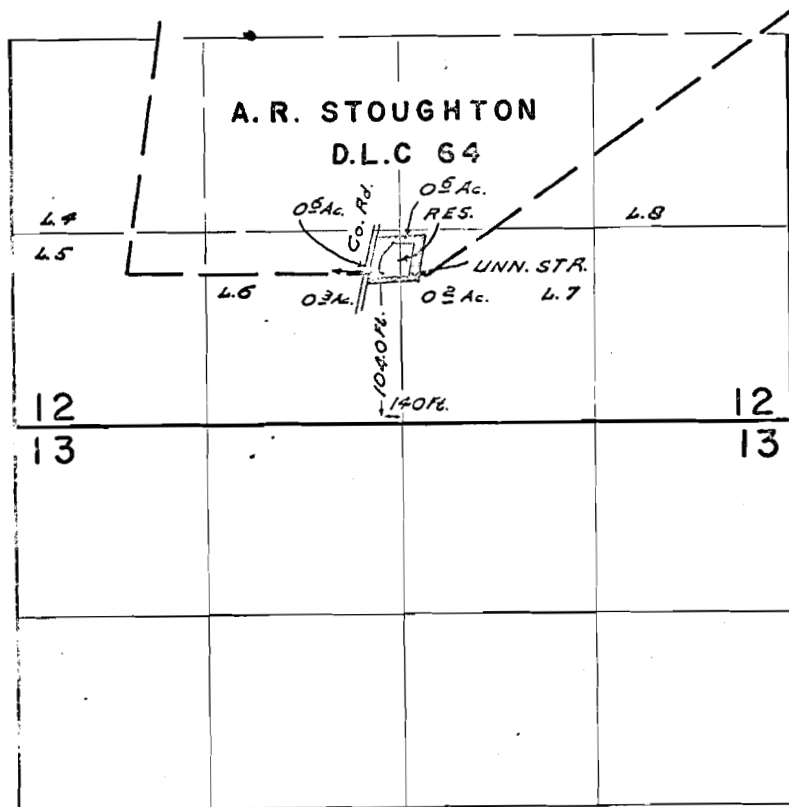

**FINAL PROOF SURVEY**  
UNDER

R - 38414

R-3223

Application No. 38415 Permit No. 28632  
IN NAME OF

A. W. TERRELL

Surveyed OCT. 21. 1965, by L. COLEBANK