


Basin 7

6-1742

33686

T.6N.R.35E.W.M.

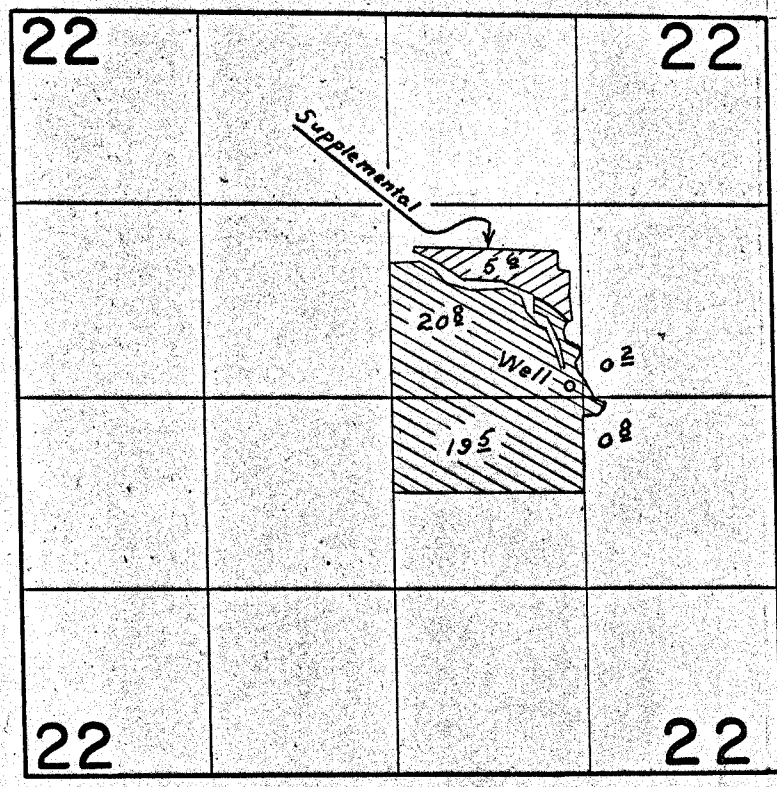

FINAL PROOF SURVEY UNDER

Application No. G-1904 Permit No. G-1742
IN NAME OF

DEAN L. & GRATIA E. BABCOCK

Surveyed April 22, 1964, by R. Jackson.....

1964-A
236