


T. I. S. R. I. W. W. M.

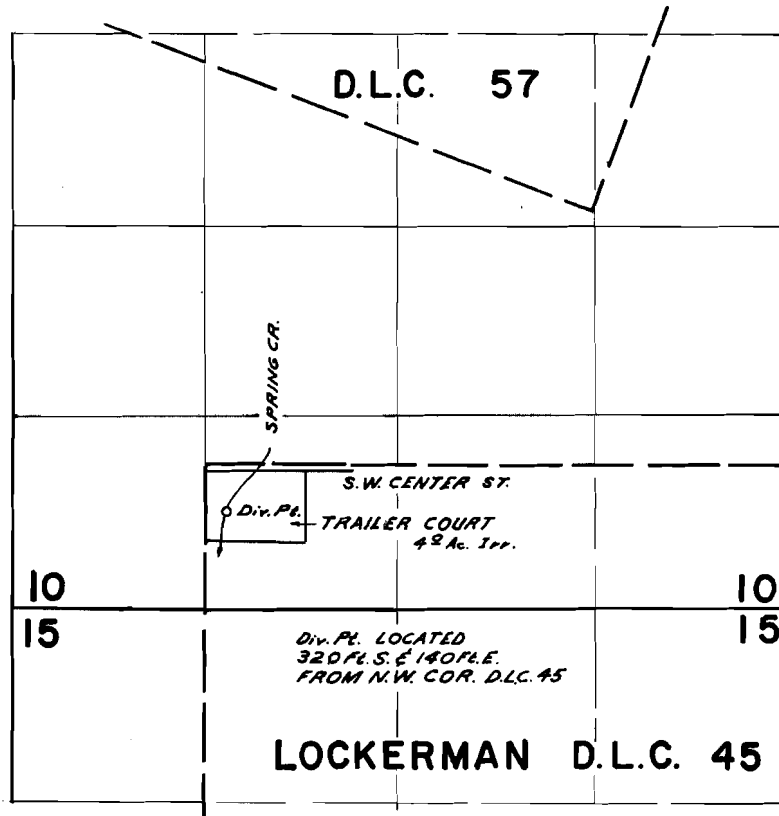

**FINAL PROOF SURVEY**  
UNDER

Application No. 40283 Permit No. 30028  
IN NAME OF

JOHN E. MEEKE, JR.

Surveyed MAY 6 1965, by L. COLEBANK