


T. 3 S. R. 2 W. W. M.

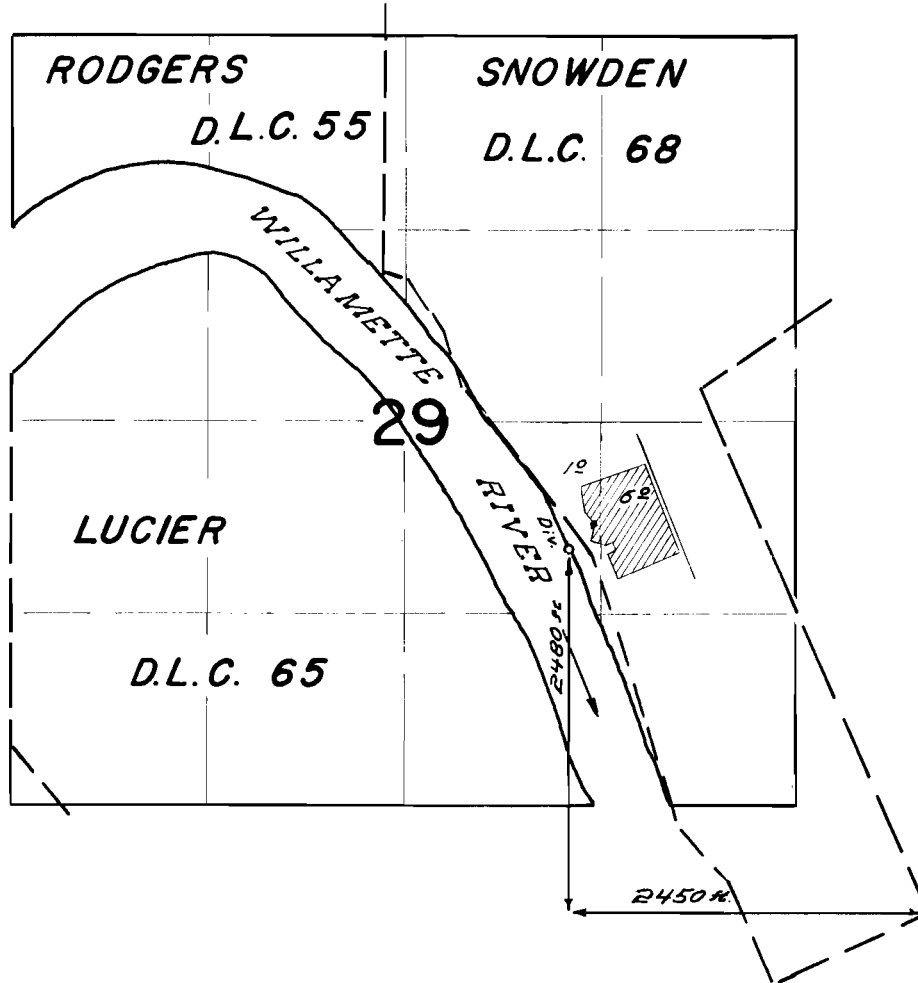

**FINAL PROOF SURVEY**  
UNDER

Application No. 37731 Permit No. 28126  
IN NAME OF

MRS. F. A. BURKETT

Surveyed AUG 6 1965, by L. COLEBANK