


T.4S. R.3W. W.M.

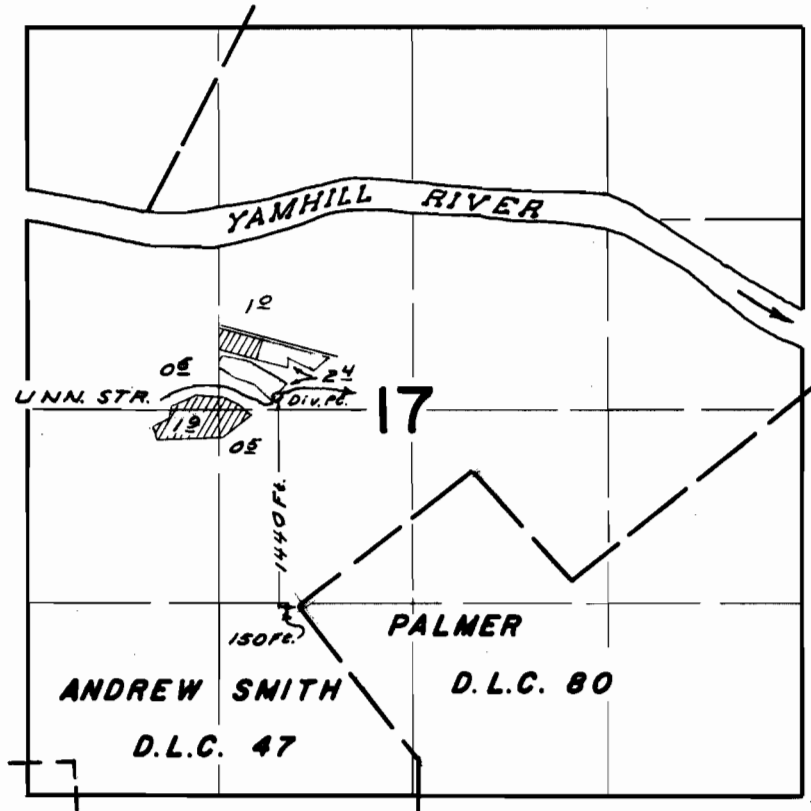

FINAL PROOF SURVEY
UNDER

Application No. 39207 Permit No. 29191
IN NAME OF

O. T. CALLAHAN

Surveyed JULY 30 1965, by L. COLEBANK