


T.5S. R.4&5W. W.M.

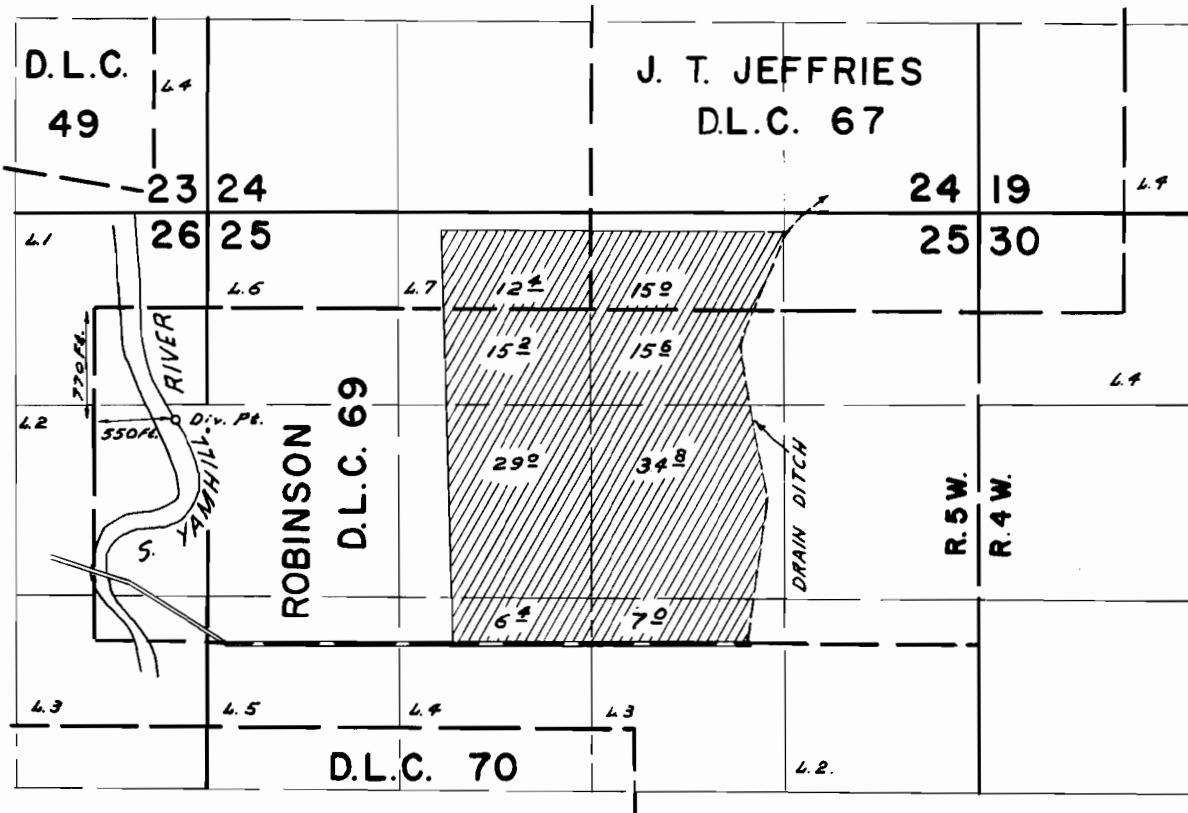

**FINAL PROOF SURVEY**  
UNDER

Application No. 38637 Permit No. 28760  
IN NAME OF

NORVAL GOFFENA

Surveyed NOV. 5 1965, by L. COLEBANK