


# T.5S.R.5W.W.M.

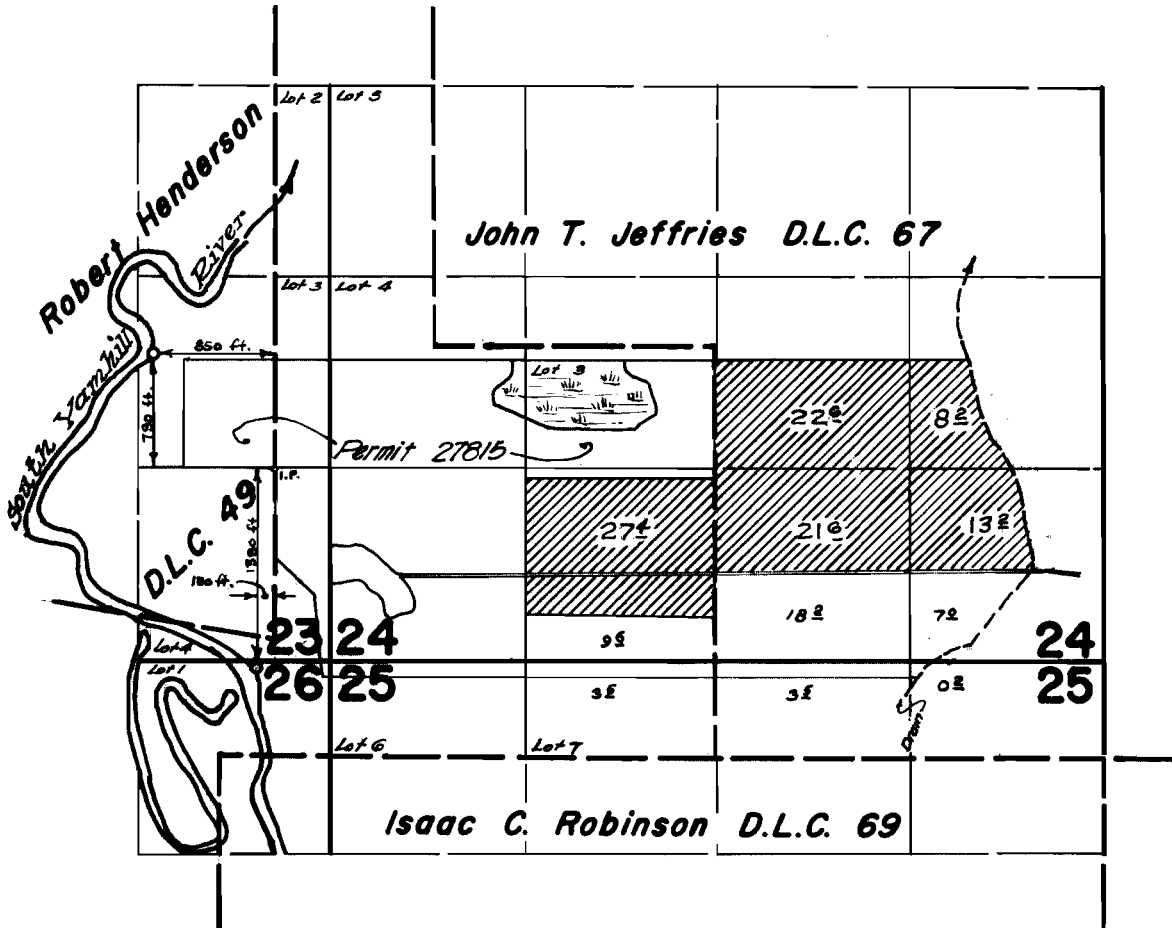

## FINAL PROOF SURVEY UNDER

Application No. **34866** Permit No. **27366**  
IN NAME OF

**D. K. HOWARD**

Surveyed August 8 1965, by *R. Jackson*