


T.4S.R.5W.W.M.

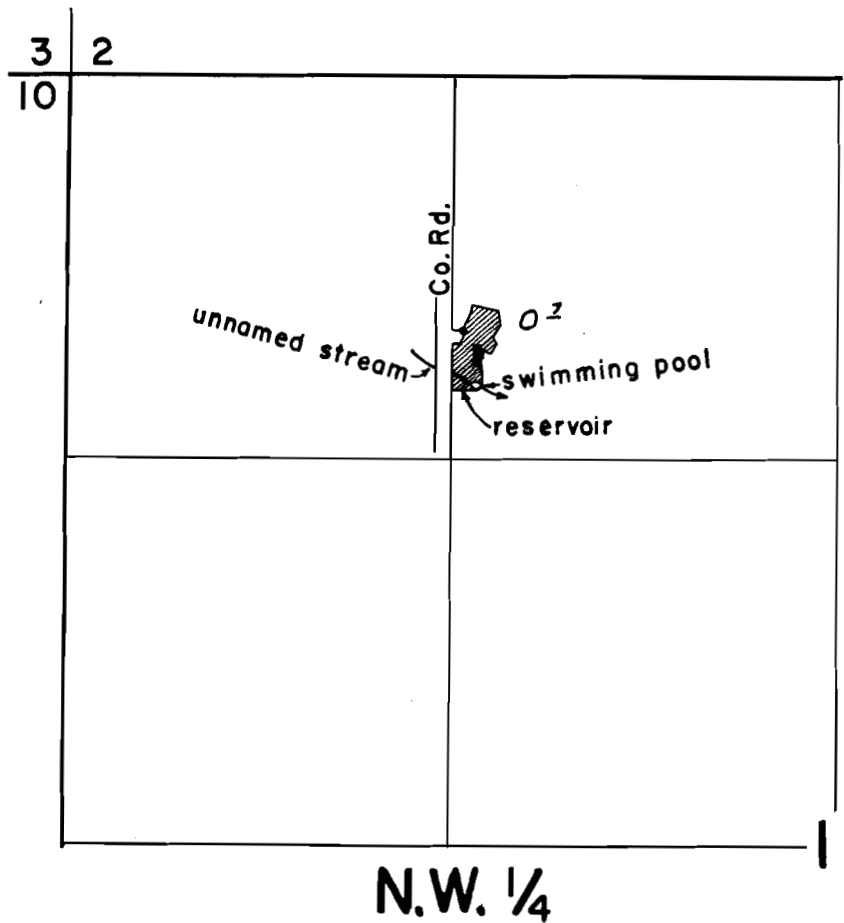

FINAL PROOF SURVEY
UNDER

R-24429 R-1945
Application No. 24216 Permit No. 24526
IN NAME OF

Stuart R. & Royce M. Keller

Surveyed Aug. 28, 1964, by R. Jackson