


T.4S. R.4W. W.M.

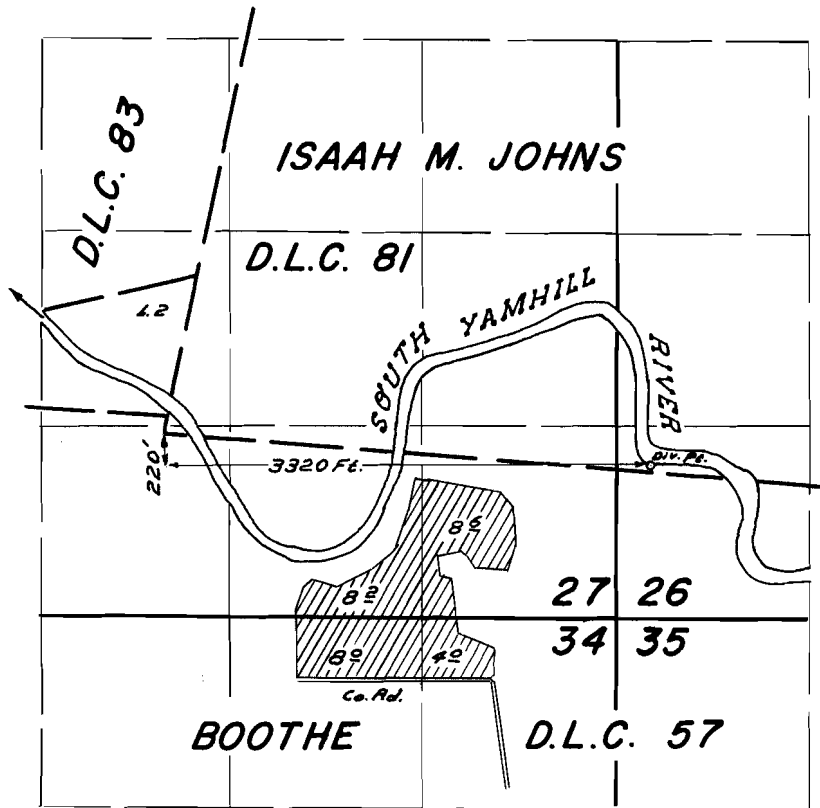

FINAL PROOF SURVEY
UNDER

Application No. 39899 Permit No. 29690
IN NAME OF

RUSSELL L. OLSON

Surveyed JULY 30, 1965 by L. COLEBANK