


T.5&6S.R.4W.W.M.

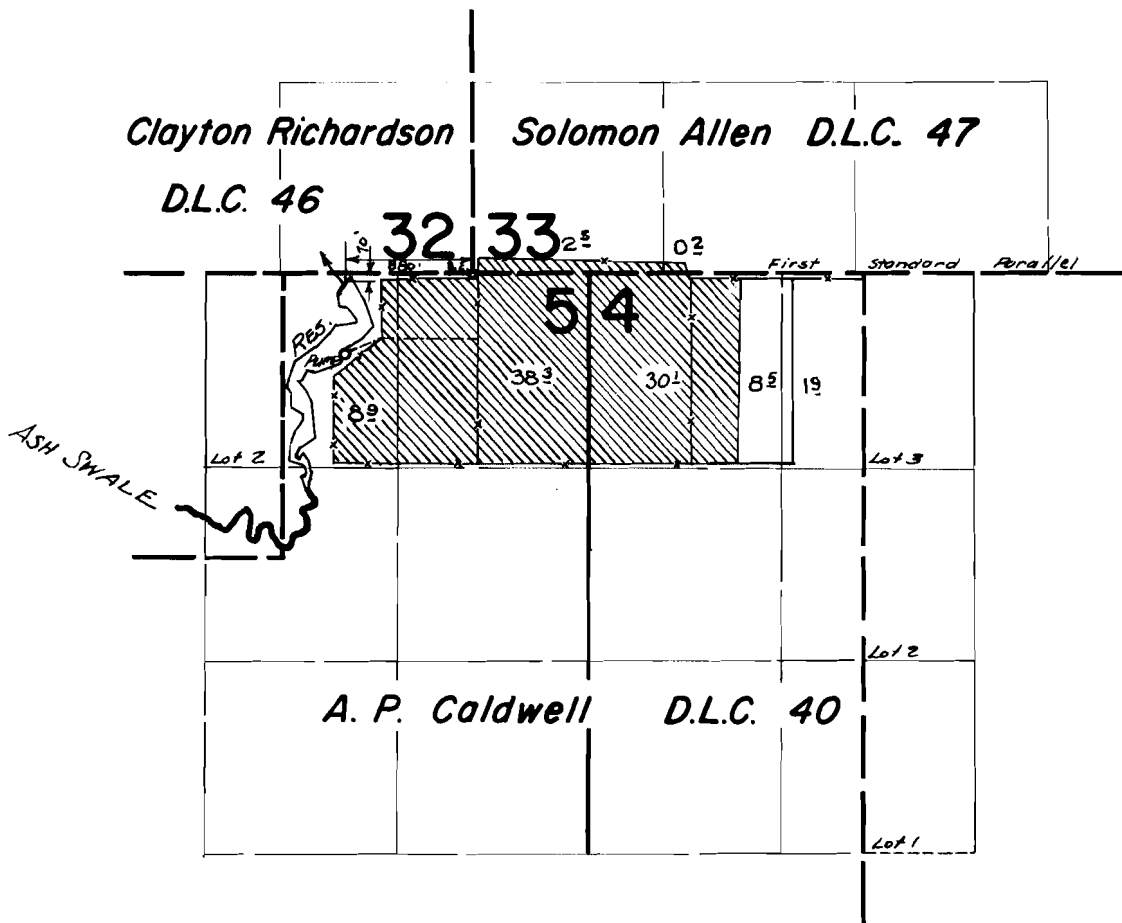

FINAL PROOF SURVEY
UNDER

R-37626 R-3159
Application No. 37627 Permit No. 28420
IN NAME OF

GLENN PATTY

Surveyed August 3 1965, by *R. Jackson*