


T.5&6S.R.4W.W.M.

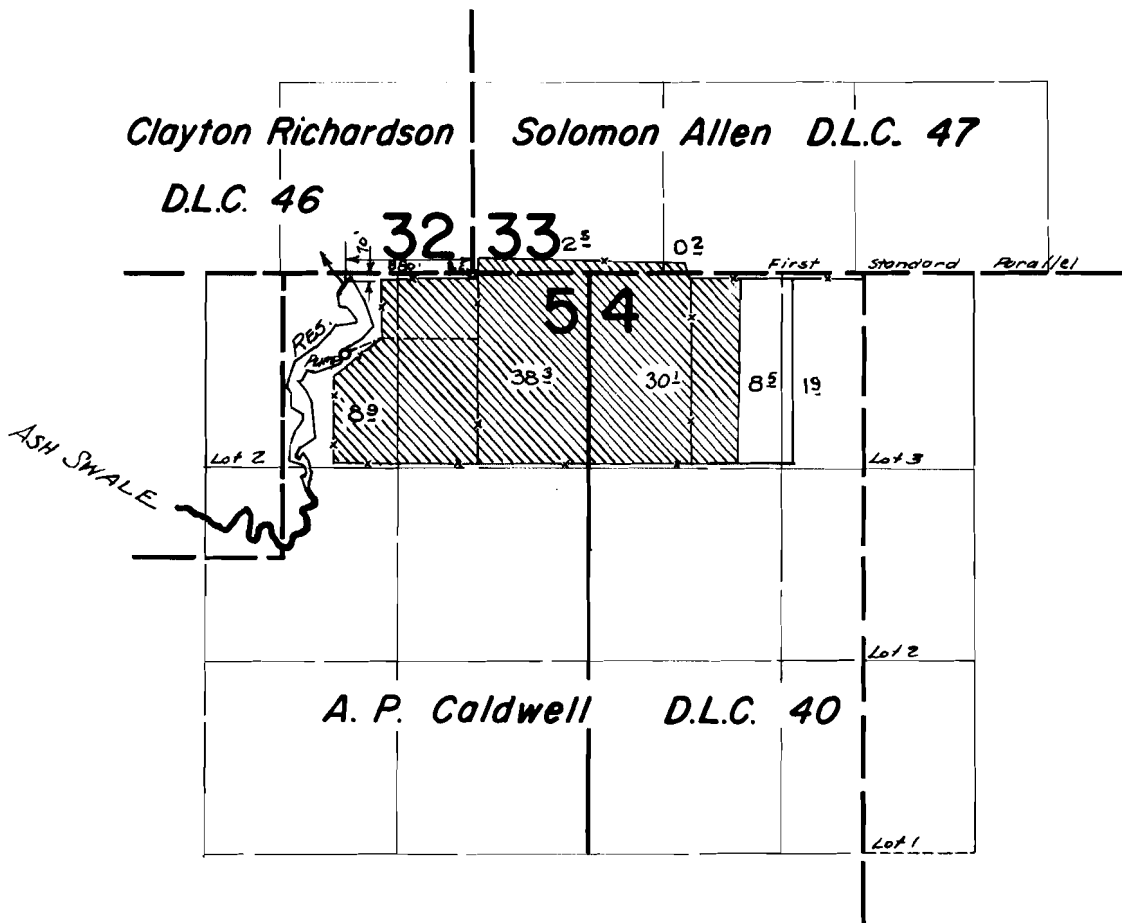

**FINAL PROOF SURVEY**  
UNDER

R-37626                      R-3159  
Application No. 37627      Permit No. 28420  
IN NAME OF

**GLENN PATTY**

Surveyed August 3 1965, by *R. Jackson*