


T.4S. R.2W. W.M.

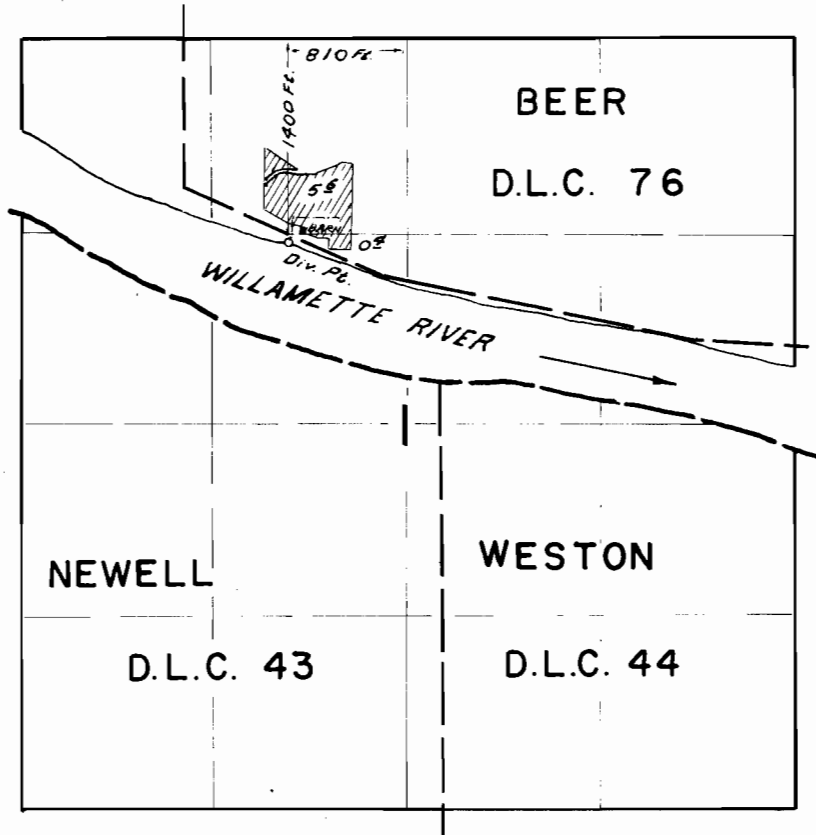

FINAL PROOF SURVEY
UNDER

Application No. 38864 Permit No. 28903
IN NAME OF

TRUMAN E. & MILDRED B. PHILLIPS

Surveyed SEPT. 22 1965, by L. COLEBANK