


T.3S. R.2&3W. W.M.

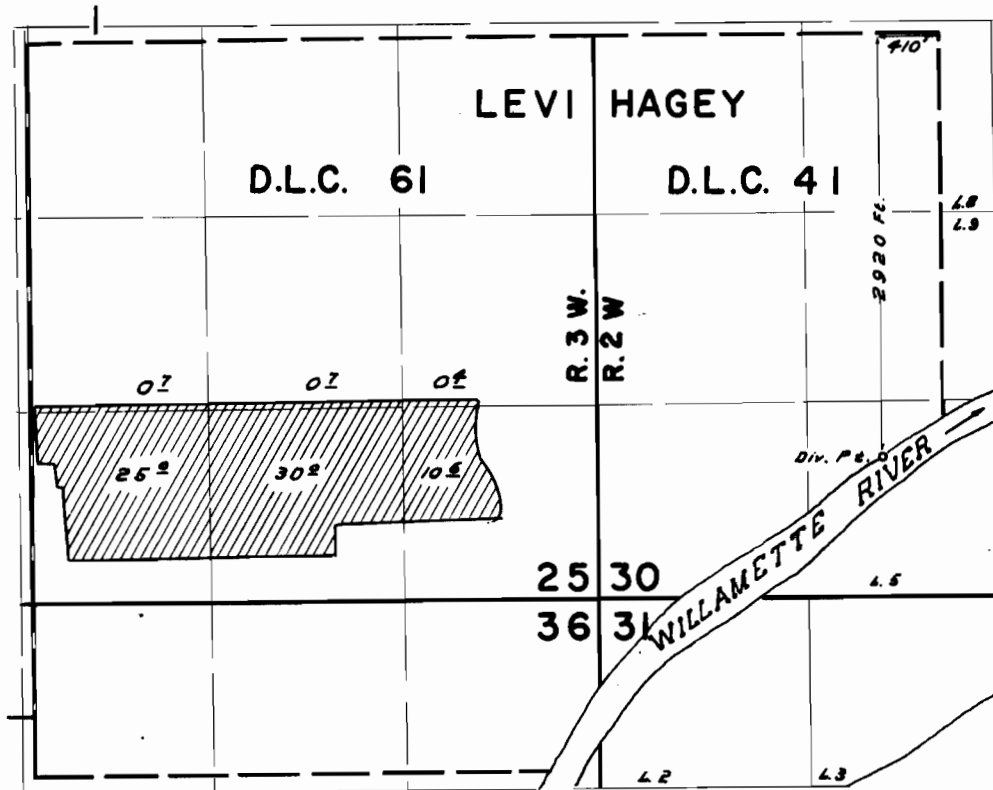

FINAL PROOF SURVEY
UNDER

Application No. 37586 Permit No. 28002
IN NAME OF

JOHN "JACK" SHELBURNE, JR.

Surveyed AUG 19 1965, by L. COLEBANK