


T.5S.R.5W.W.M.

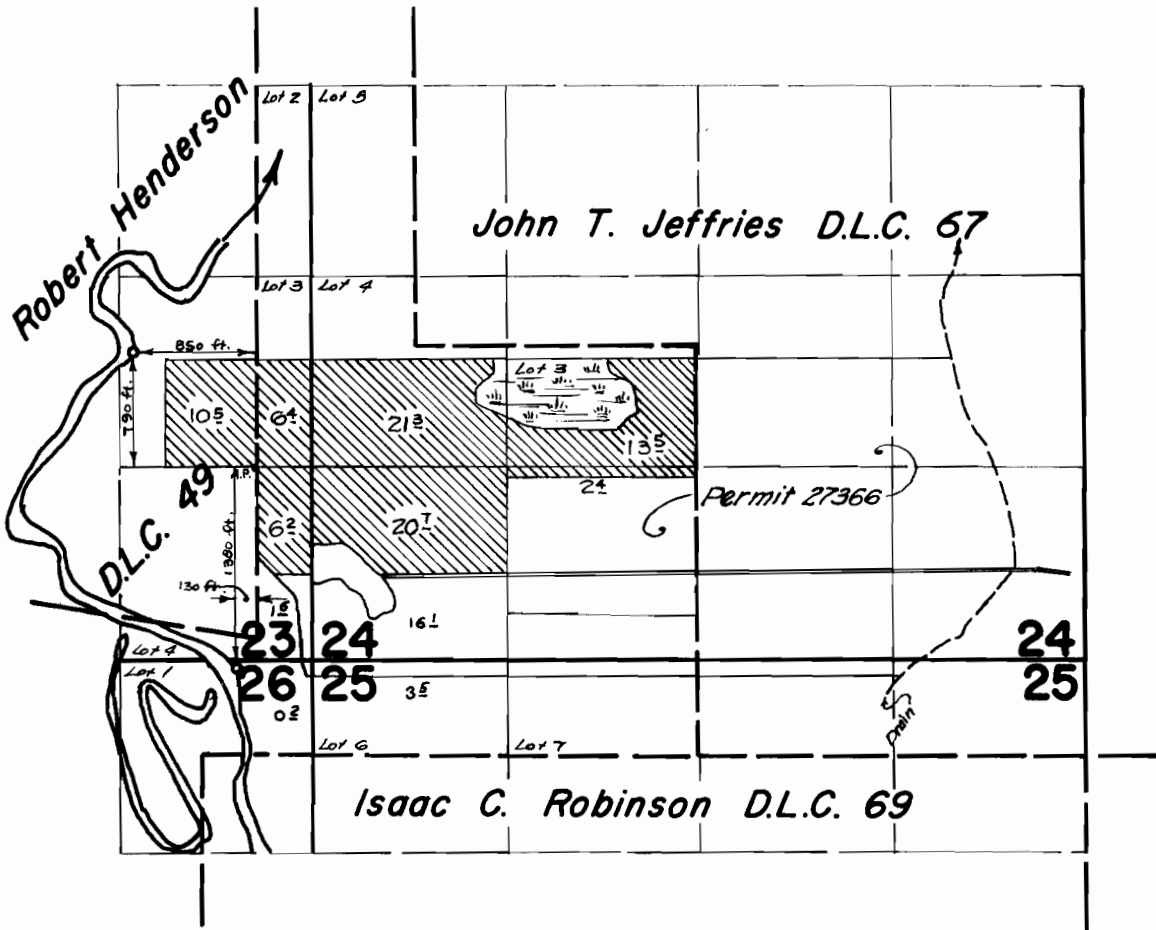

**FINAL PROOF SURVEY**  
UNDER

Application No. **37366** Permit No. **27815**  
IN NAME OF

**GALE B. VINTON**

Surveyed *August 8, 1965*, by *R. Jackson*