


WORK COPY (plan for cert: 33471)

T.5&6S.R.1W.8&1E.W.M.

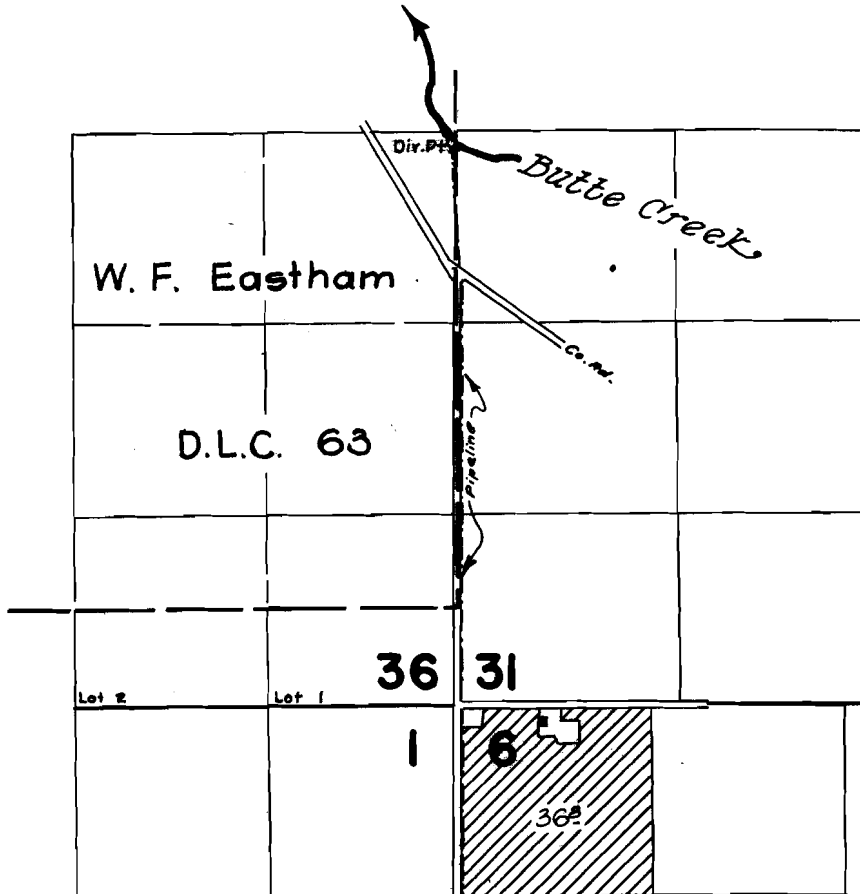

FINAL PROOF SURVEY
UNDER

Application No. 34655... Permit No. 27221...
IN NAME OF

ALMA MEDACIZ

Surveyed May 3, 1963, by T. LAUER

