


T. 3 S. R. 5 W. W.M.

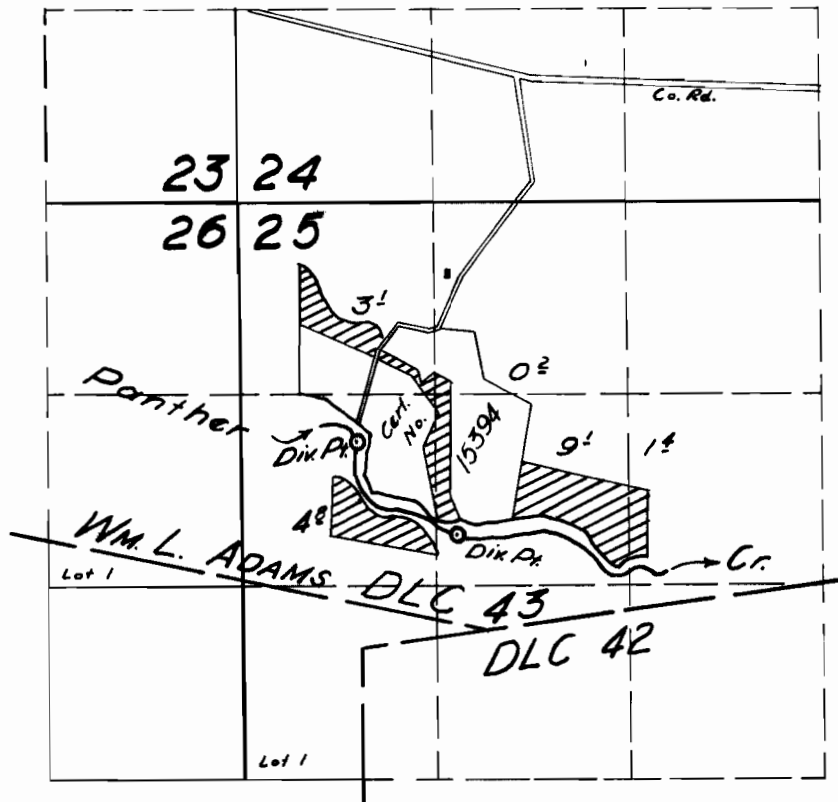

FINAL PROOF SURVEY

UNDER

Application No. 24179 Permit No. 19915

IN NAME OF

H. A. WELLS

Surveyed 3 Apr 1956, by [Signature]