


T.35S.R.1W.W.M.

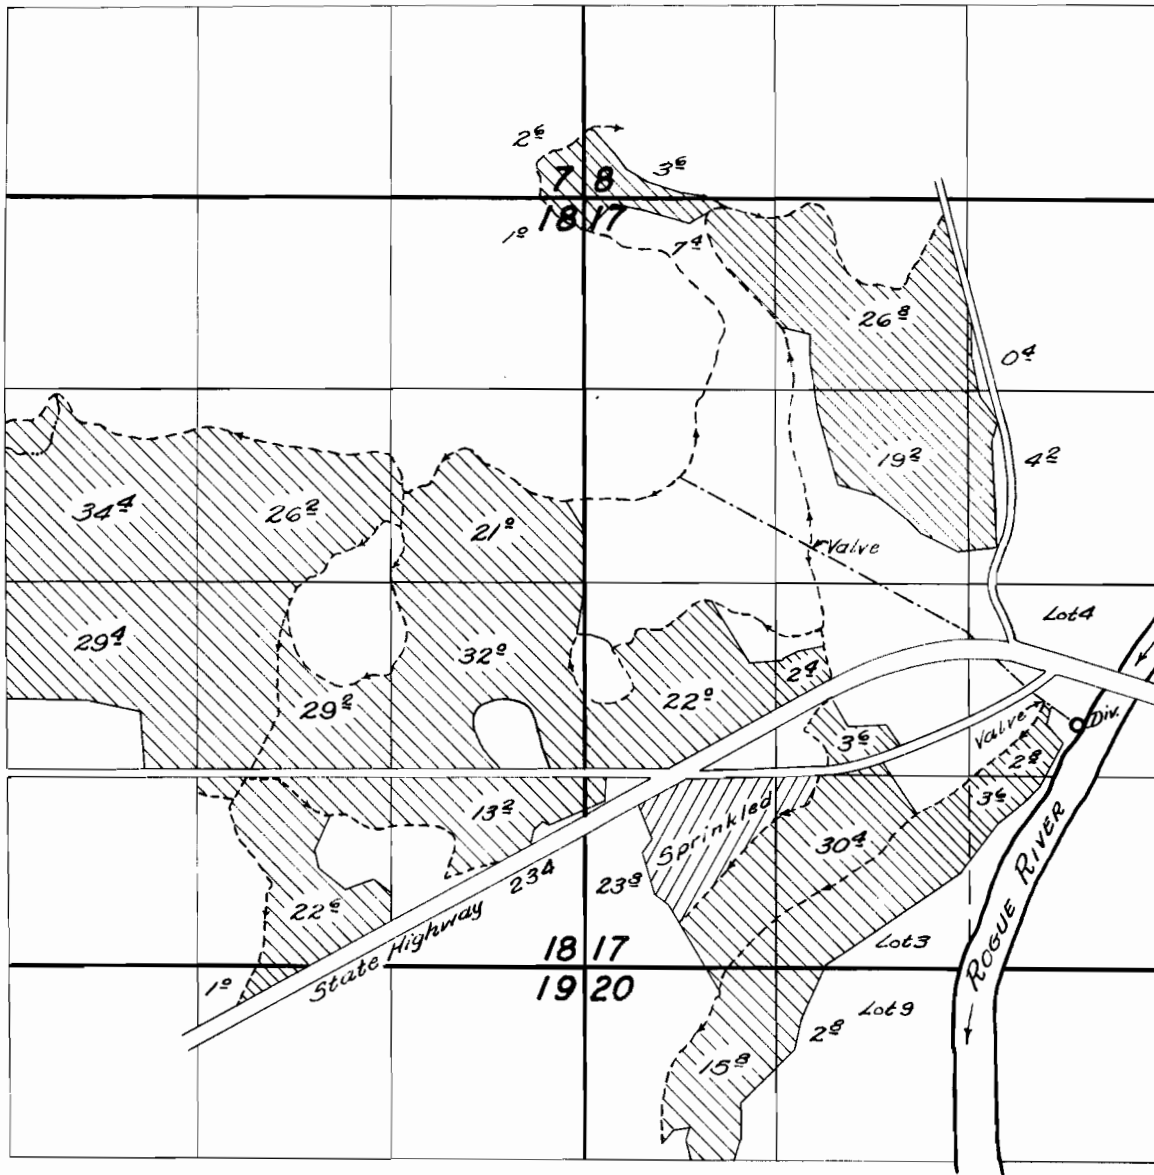

**FINAL PROOF SURVEY
UNDER**

**APPL. NO. 197 PERMIT NO. 298
IN NAME OF**

B. L. DODGE

SURVEYED MAY 8,12,13, 1959 BY C. O. Baetels