


T. 11 S. R. 5 W. W. M.

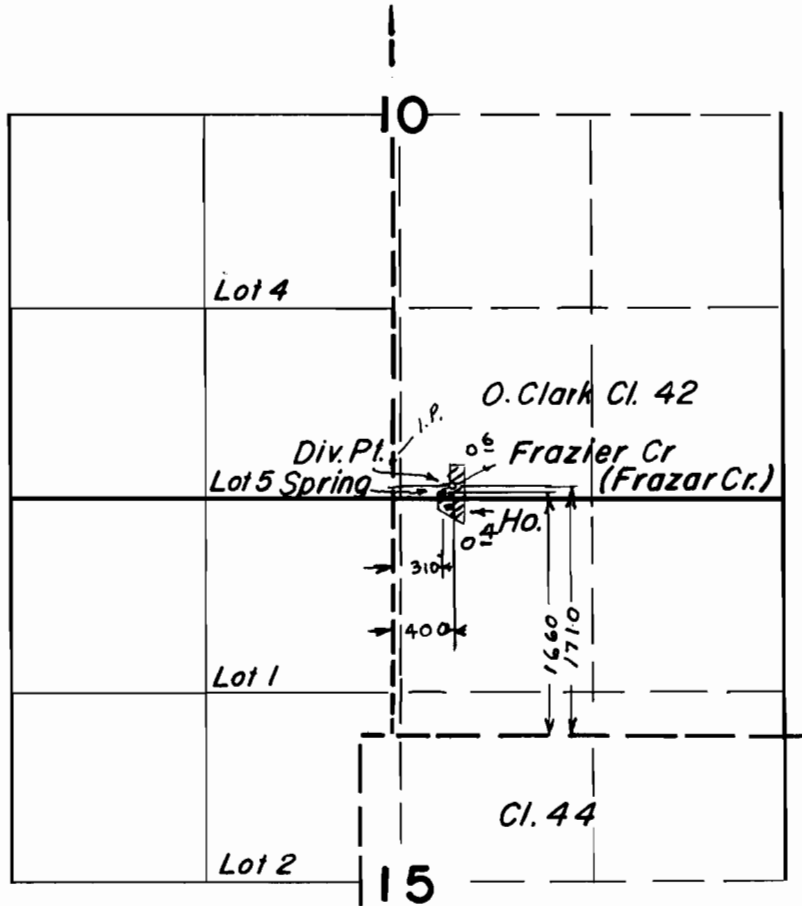

FINAL PROOF SURVEY
UNDER

Application No. 37222 Permit No. 27739
IN NAME OF

David W. & Katherine K. Digby

Surveyed July 23 1965, by F. Siegmund