


T. 14 S. R. 8 W. W. M.

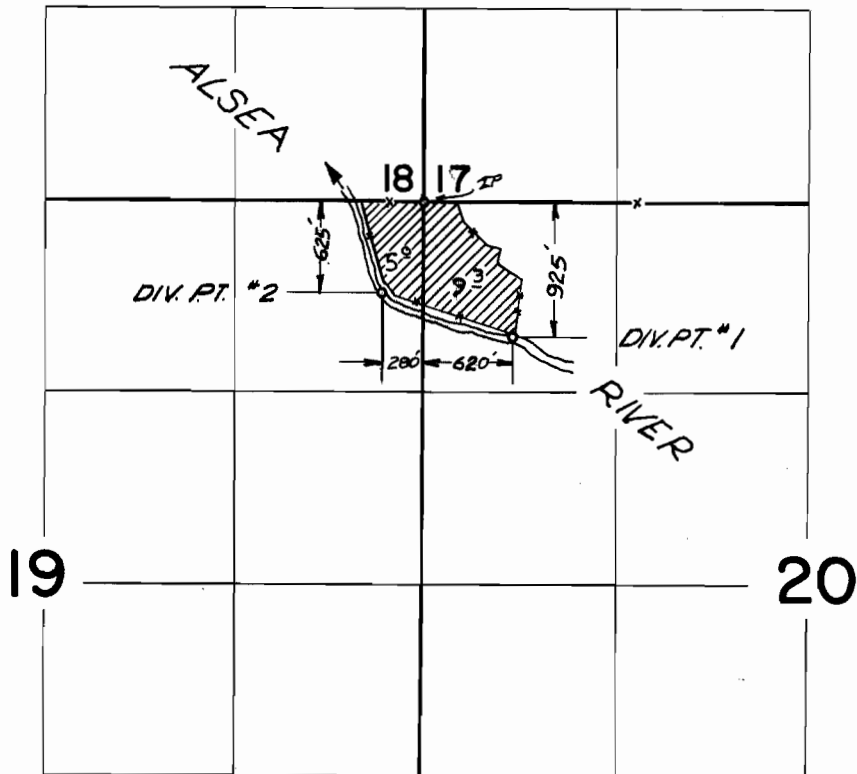

FINAL PROOF SURVEY
UNDER

Application No. 33756 Permit No. 26654
IN NAME OF

VERNON B. and VERDA E. HALL

Surveyed April 12 1966, by V. GARNER