


T. 12S. R.5 & 6W.W.M.

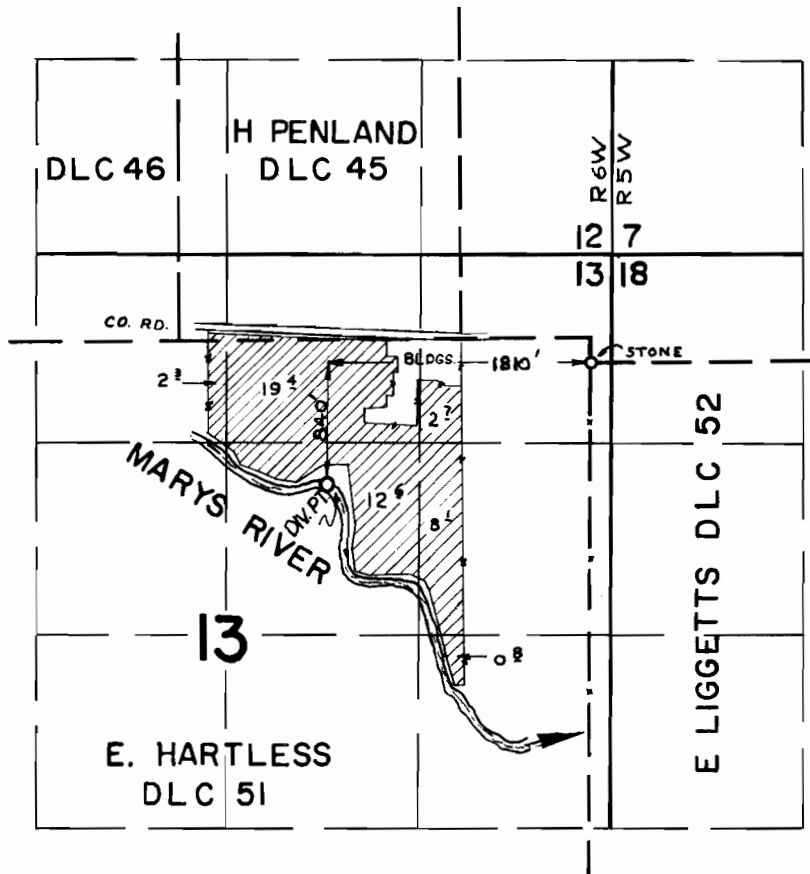

FINAL PROOF SURVEY
UNDER

Application No. 38482 Permit No. 28656
IN NAME OF

R. C. MCKELVIE

Surveyed APRIL 6 1966, by V. GARNER