


# T. 11 S. R. 4 W. W.M.

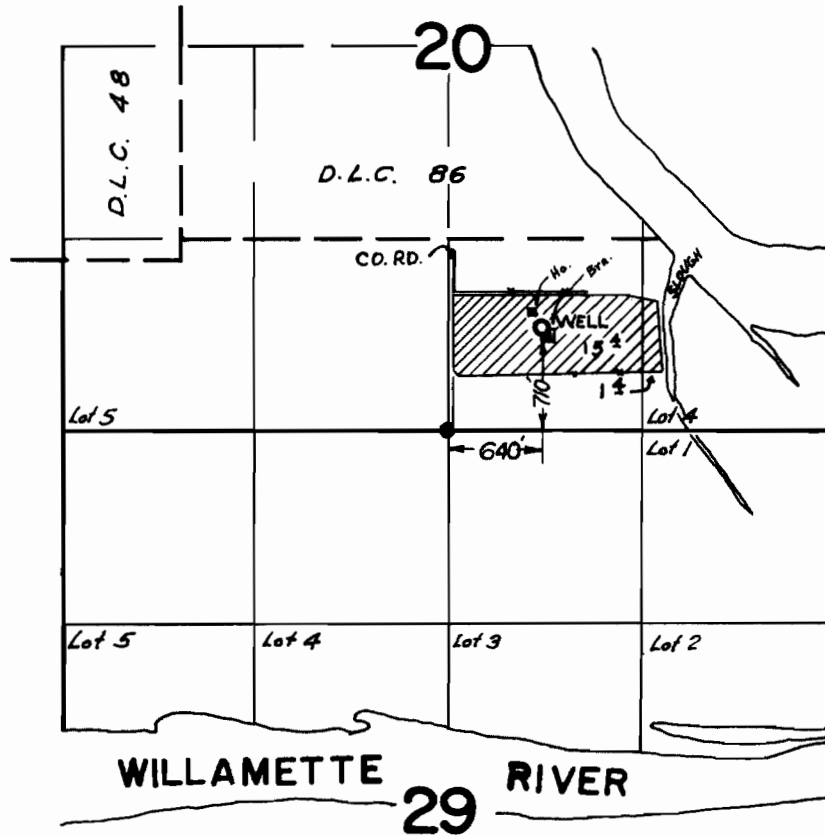

## FINAL PROOF SURVEY UNDER

Application No. G-3154... Permit No. G-2968.  
IN NAME OF

AARON G RICTOR

Surveyed APRIL 5, 1966., by V. GARNER