


T. 12 S. R. 6 W. W.M.

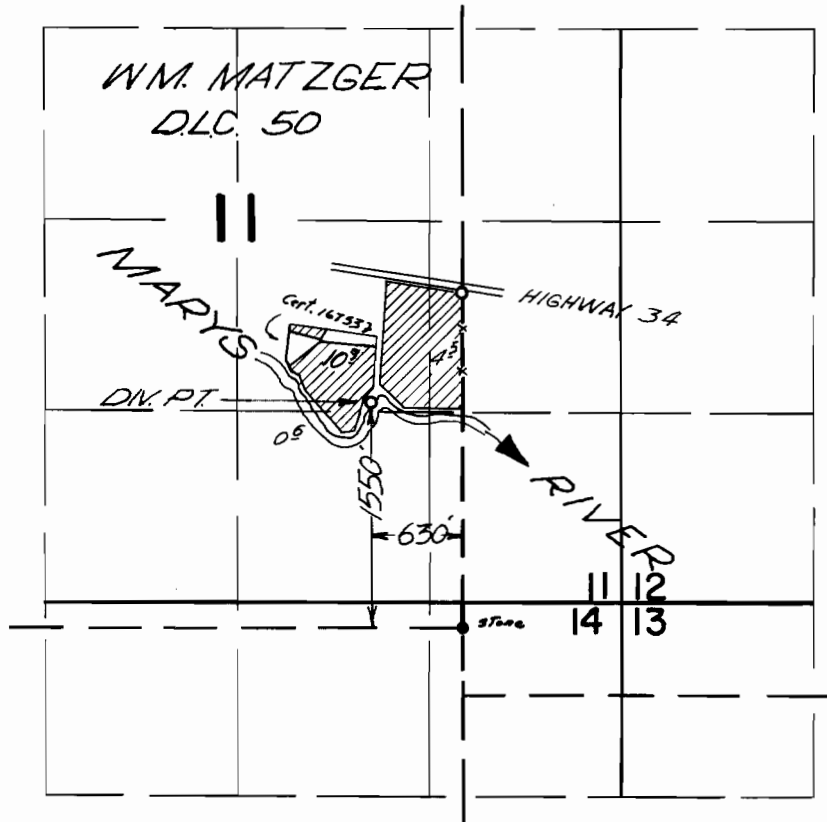

FINAL PROOF SURVEY UNDER

Application No. 35049 Permit No. 27446
IN NAME OF

LEON B. STRATTON

Surveyed April 20 1966, by V. GARNER