


T.14S.R.8&9W.W.M.

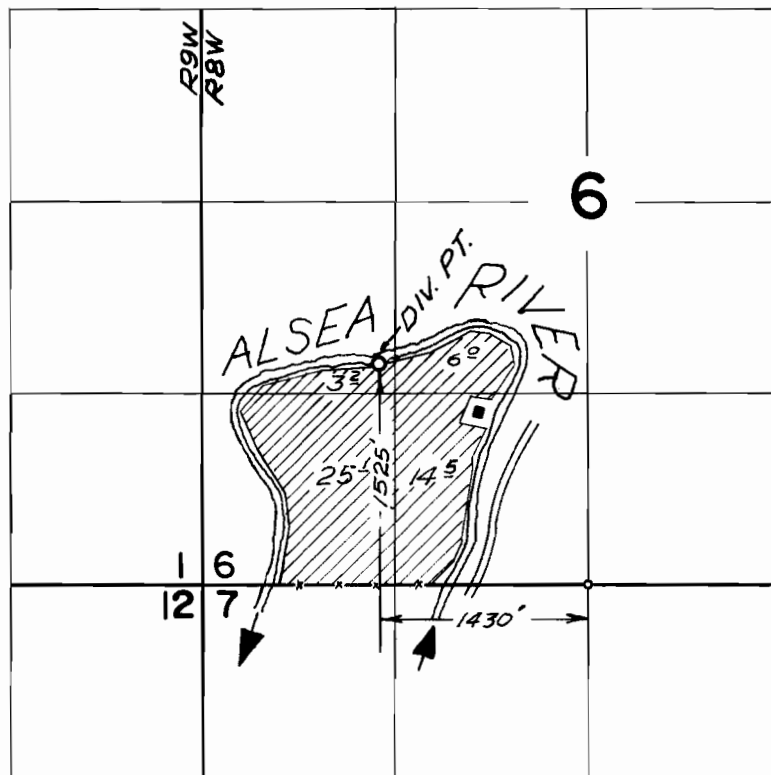

FINAL PROOF SURVEY
UNDER

Application No. 38685... Permit No. 28782...
IN NAME OF

RICHARD E. VAILE

Surveyed April 18 1966, by V. GARNER.....