


T. 3S. R. 1W. W.M.

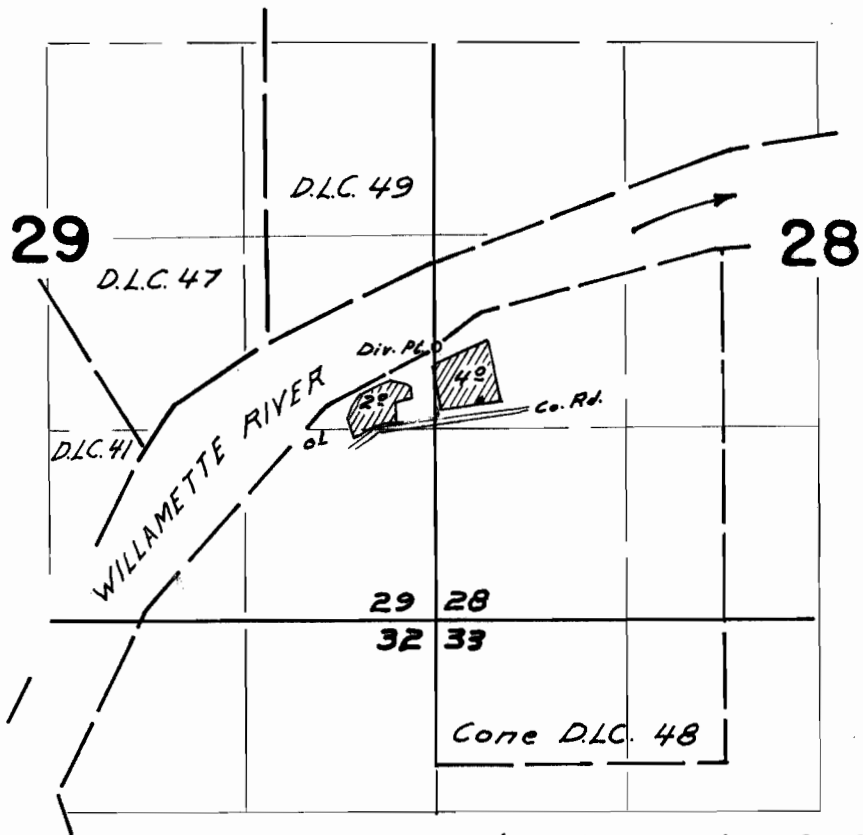

DIVERSION POINT 1880 ft N.E. 10 ft E. FROM S.W. Cor. Sec. 28

FINAL PROOF SURVEY UNDER

Application No. 33/01 Permit No. 26/93
IN NAME OF

Dan Clark

Surveyed Aug 24 1964, by C. Gardner
Oct 20, 1966 W.J. Ruppert