


T. 4N. R. 2 W. W.M.

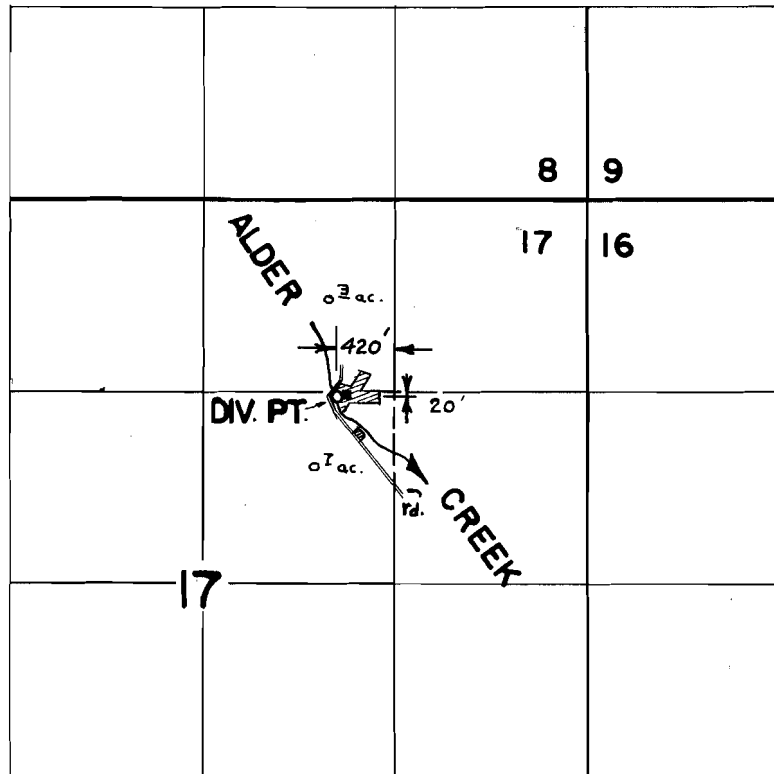

FINAL PROOF SURVEY
UNDER

Application No. 39998... Permit No. 29841...
IN NAME OF

.....HELEN.....STILSON.....

Surveyed April 1ST 19.66, by *V. Harner*.....