


T.28S. R.14W. W.M.

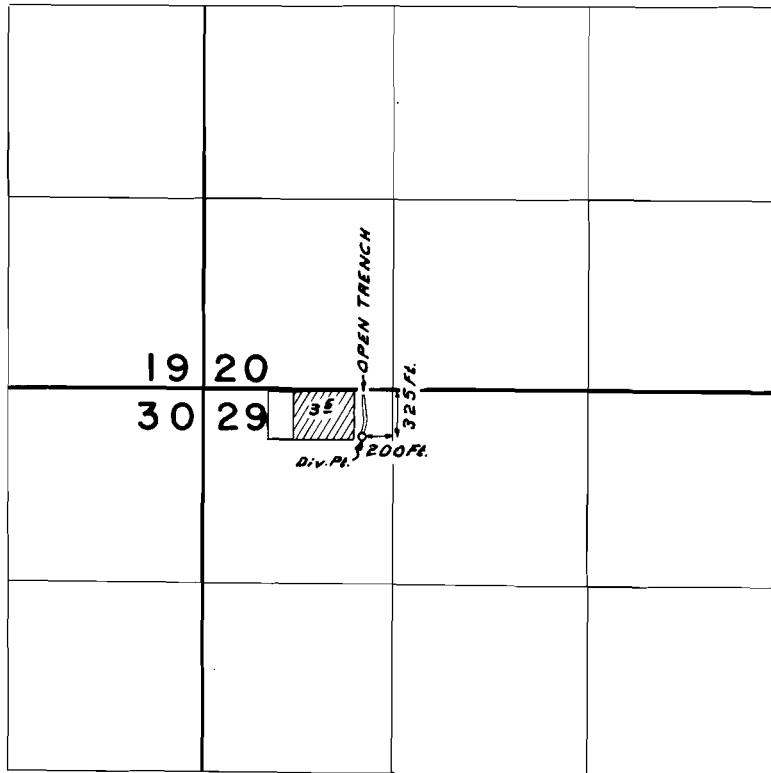

FINAL PROOF SURVEY
UNDER

Application No. G - 3063 Permit No. G-2856
IN NAME OF

RAY W. & W. R. BATES

Surveyed AUG 24 1965, by L. COLEBANK