


T.27S.R.13W.W.M.

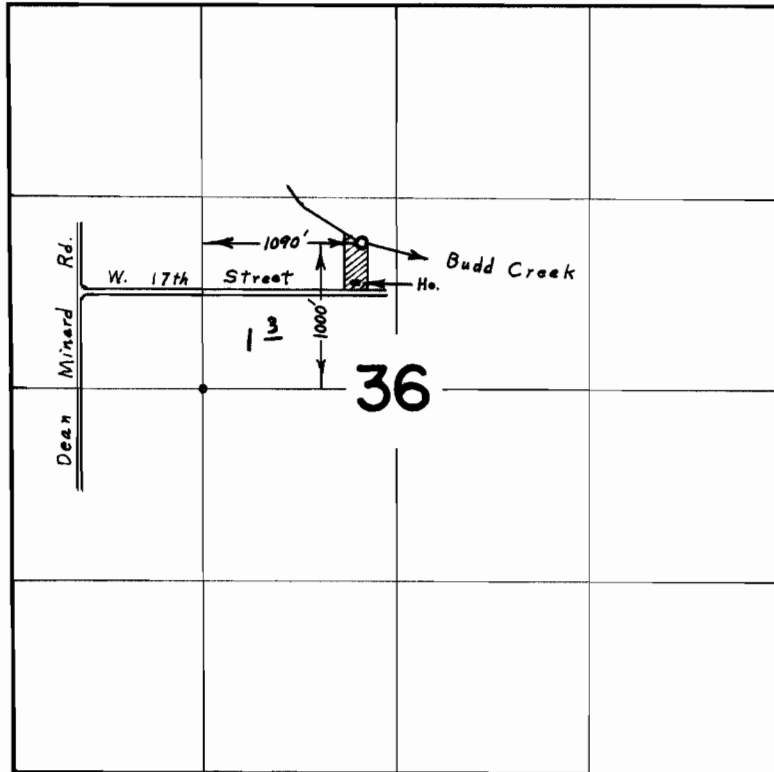

FINAL PROOF SURVEY
UNDER

Application No. 39902 Permit No. 29700
IN NAME OF

EDWARD W. FREDRICKSON

Surveyed Oct. 11, 1966, by L. E. Gould