


T.29S. R.12W. W.M.

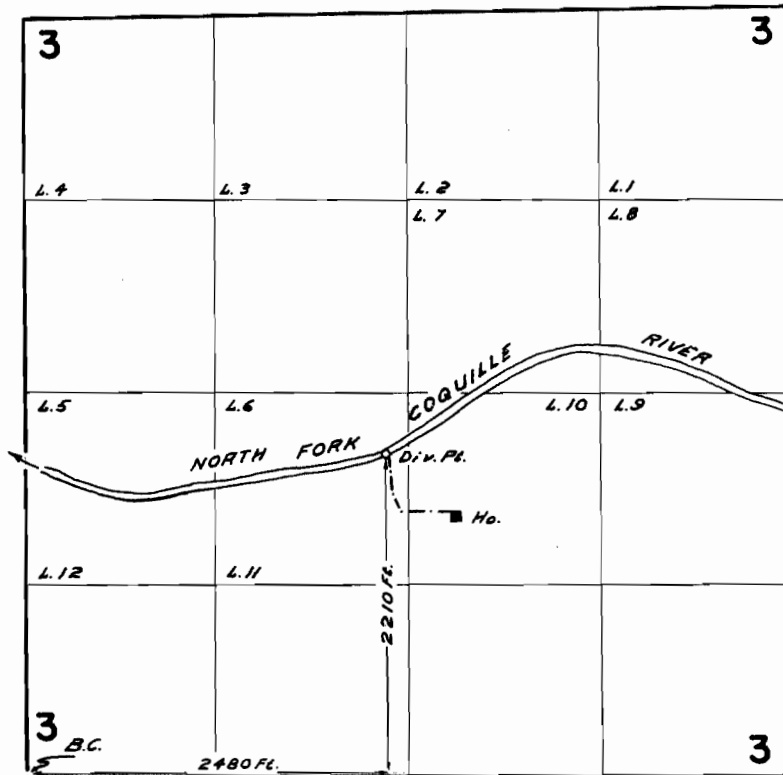

FINAL PROOF SURVEY
UNDER

Application No. 39698 Permit No. 29624
IN NAME OF

WILLIAM E. HARPER

Surveyed SEPT 2 1965, by L. COLEBANK