


T.28S. R.12W. W.M.

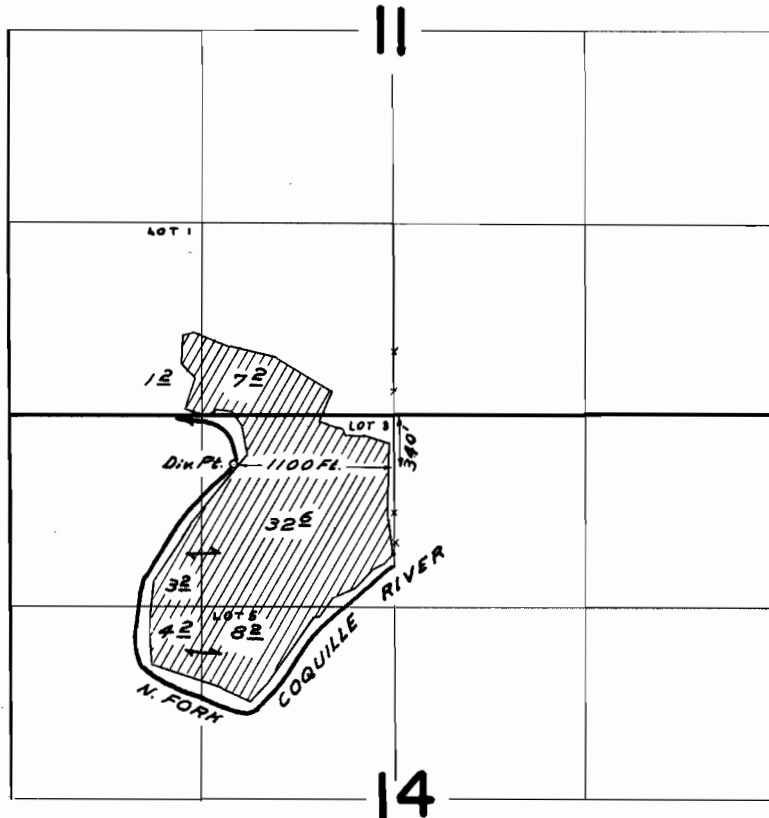

FINAL PROOF SURVEY
UNDER

Application No. 39432 Permit No. 29294
IN NAME OF

INGRAM BROTHERS

Surveyed AUG 31 1965, by L. COLEBANK