


T.28S. R.12W. W.M.

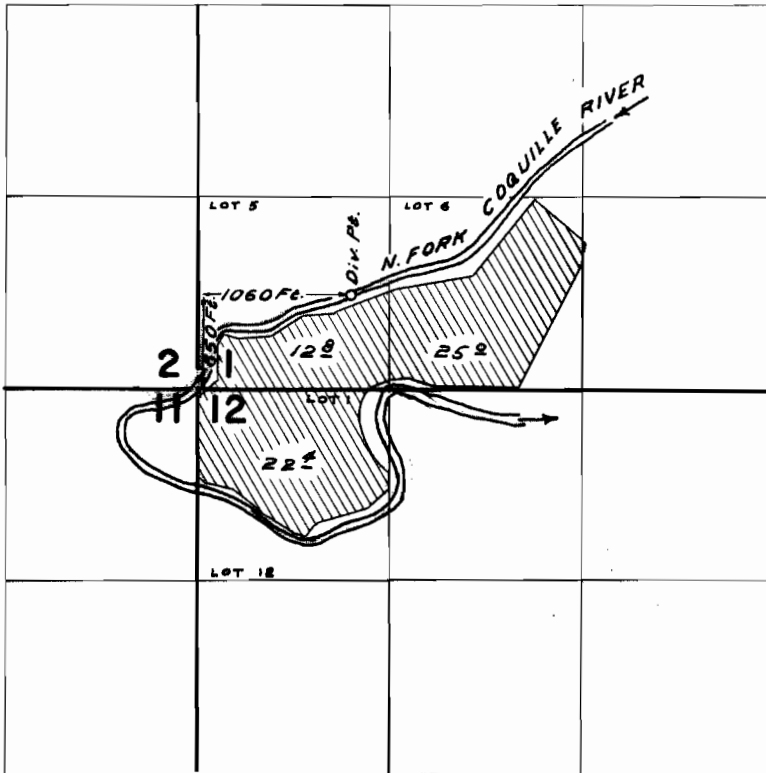

**FINAL PROOF SURVEY**  
UNDER

Application No. 39489 Permit No. 29313  
IN NAME OF

LLOYD K. MAST

Surveyed AUG 28 1965, by L. COLEBANK

1866 W. 244