


T.28S. R.12 & 13W. WM.

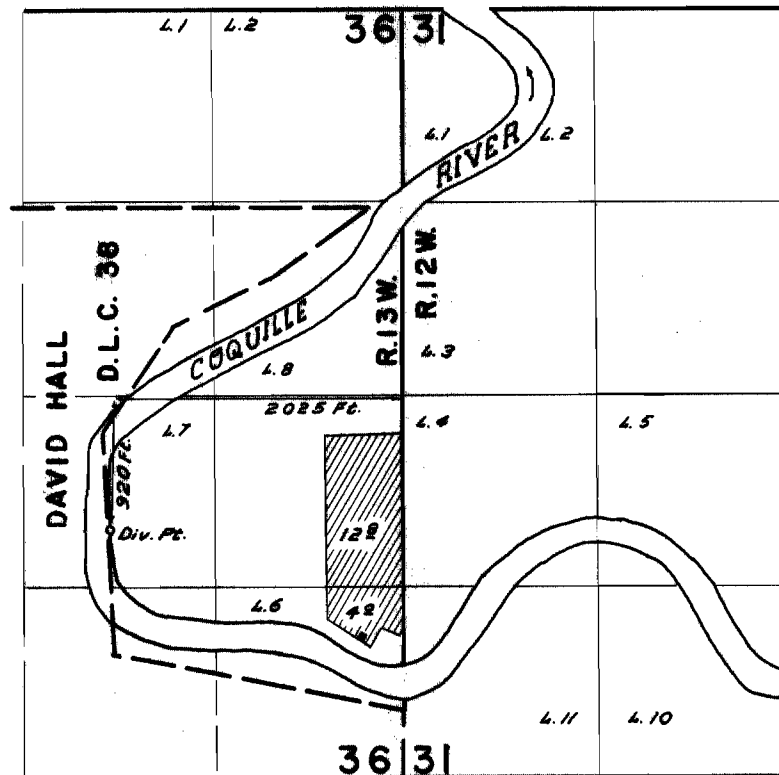

FINAL PROOF SURVEY
UNDER

Application No. 34024 Permit No. 26834
IN NAME OF

KNUD EINER NIELSEN

Surveyed AUG 27 1965, by L. COLEBANK