


T. 29 S. R. 12 W. W.M.

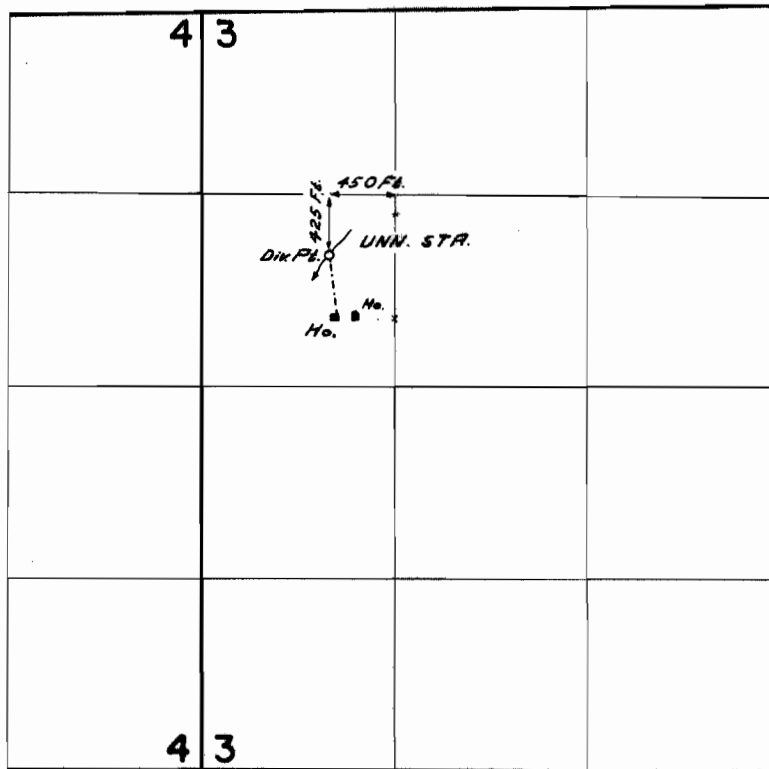

FINAL PROOF SURVEY
UNDER

Application No. 3.3.9.7.7 Permit No. 26.819.
IN NAME OF

ROBERT A. & NELLIE M. PALMER

Surveyed SEPT 2 1965. by L. COLEBANK