


T.23S.R.12W.W.M.

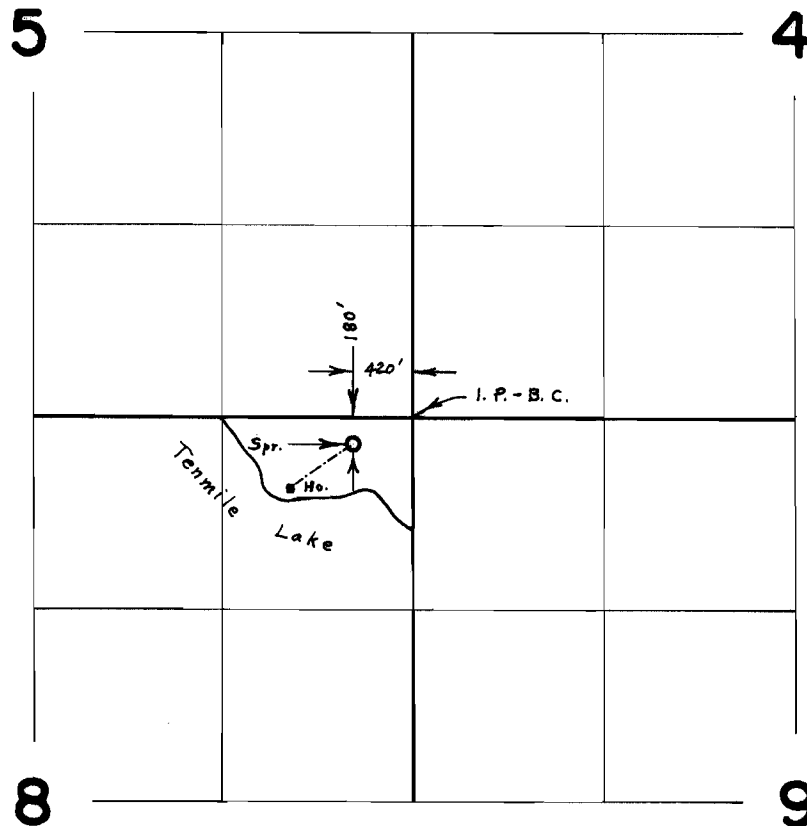

FINAL PROOF SURVEY
UNDER

Application No. 38937 Permit No. 29030
IN NAME OF

CARL A. SANDINE

Surveyed Sept. 17, 1966, by L. E. Gould