


T.23S.R.12W.W.M.

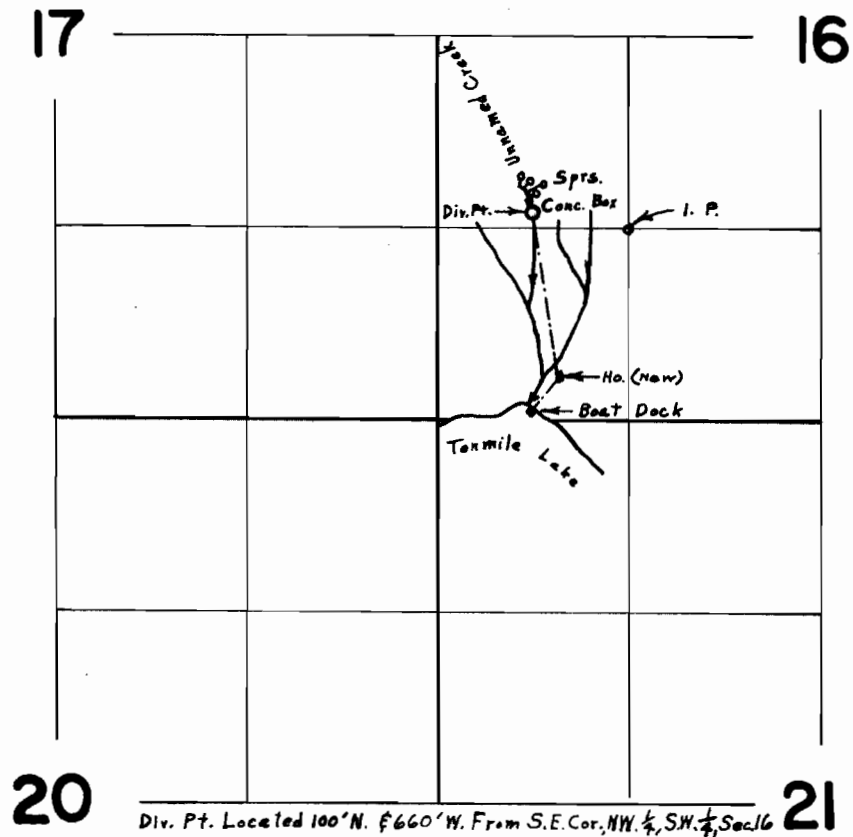

FINAL PROOF SURVEY
UNDER

Application No. 33892 Permit No. 26707
IN NAME OF
V. L. REAVIS

Surveyed Sept. 20, 1966, by L. E. Gould