


T.28S. R.12W. W.M

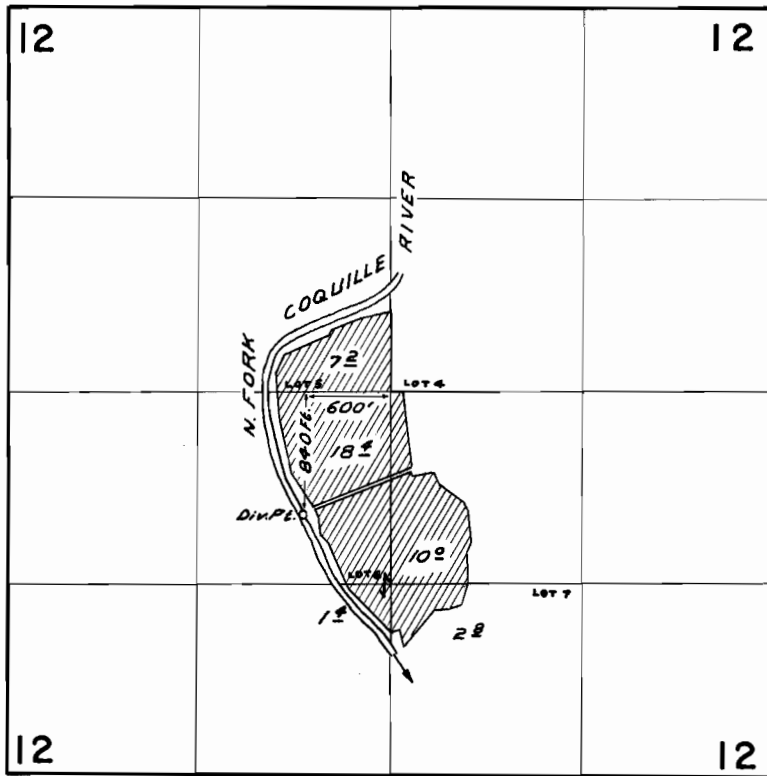

**FINAL PROOF SURVEY**  
UNDER

Application No. 39471 Permit No. 29304  
IN NAME OF

A. F. STRANGE

Surveyed AUG 30 1965, by L. COLEBANK