


T. 41 S. R. 12 W. W.M.

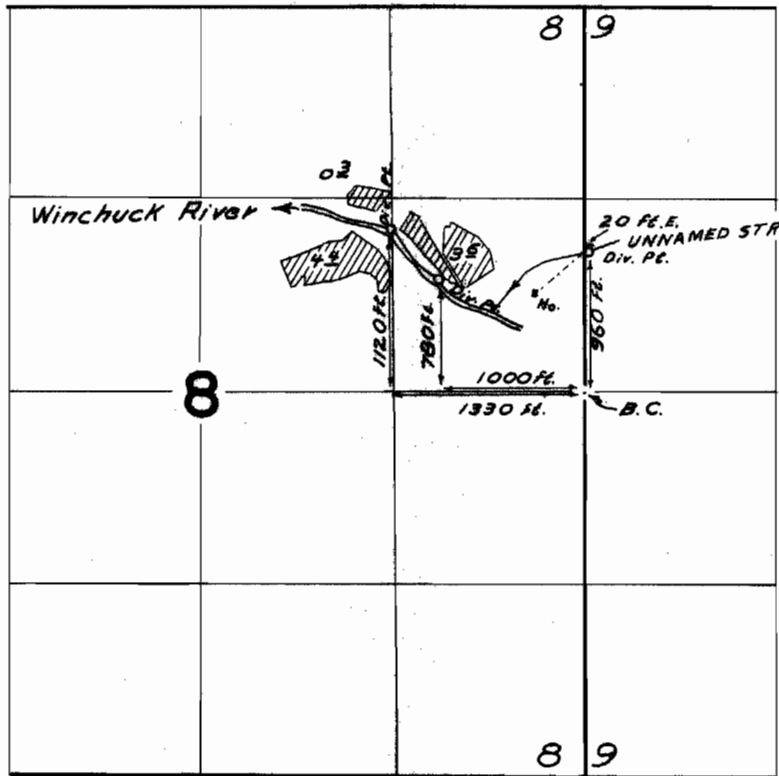

FINAL PROOF SURVEY
UNDER

Application No. 39744 Permit No. 29489
37721 IN NAME OF

DR. EUGENE F. BOWLIN

Surveyed Sept. 14 1966, by W. J. Ruppert