


T.32S.R.15W.W.M.

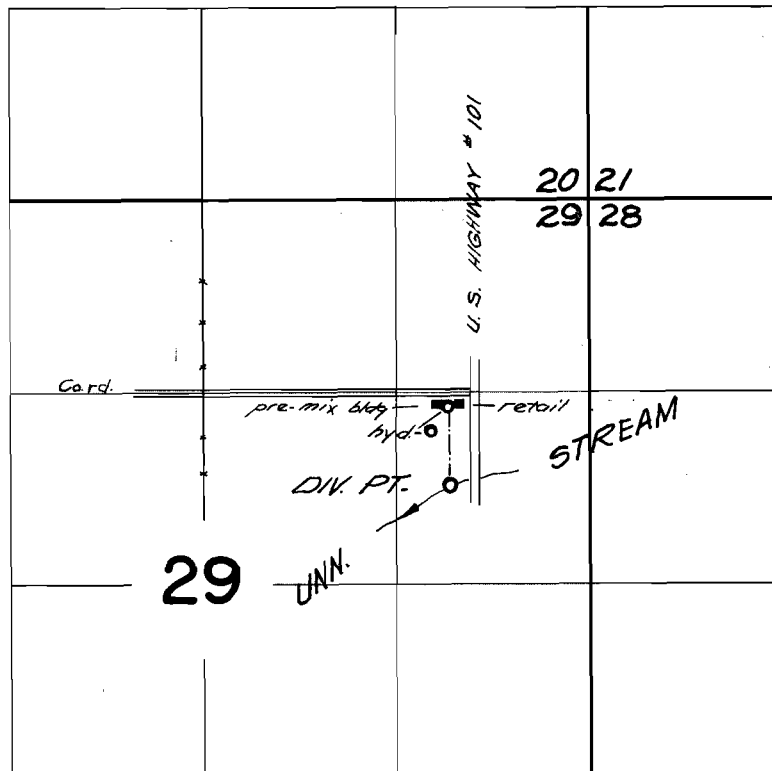

Div. Pt. located 640 ft. S. & 1680 ft. E. from the
NW cor. SW $\frac{1}{4}$, NE $\frac{1}{4}$ of Section 29

FINAL PROOF SURVEY
UNDER

Application No. 39950 Permit No. 29732
IN NAME OF

WESTERN BUILDERS SUPPLY INC.

Surveyed Sept 13 1966, by V. GARNER