
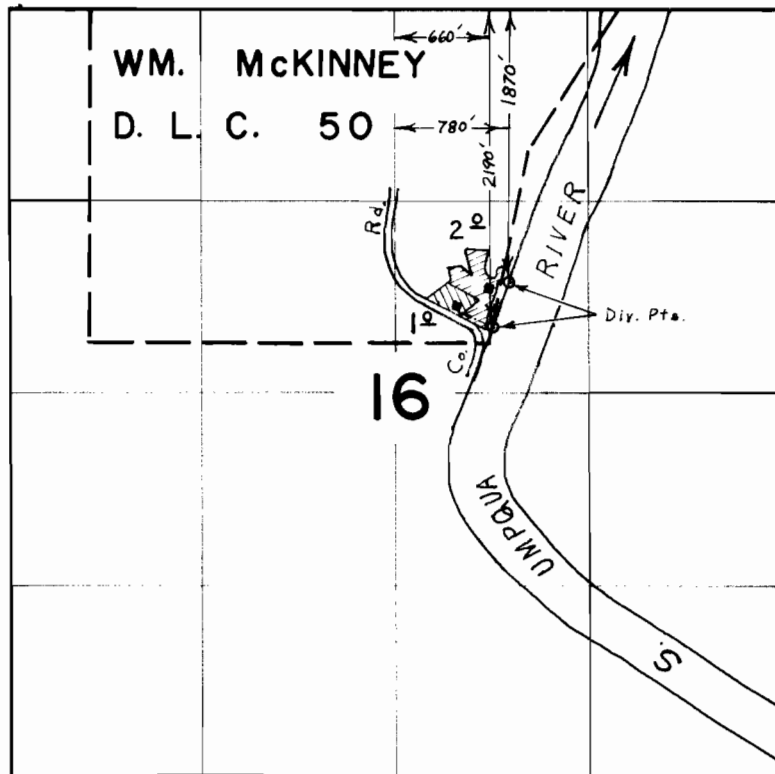
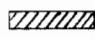


# T.27S.R.6W.W.M.

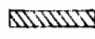

Irrigated From N. Div. Pt. 

Irrigated From S. Div. Pt. 

## FINAL PROOF SURVEY UNDER

Application No. **38038** Permit No. **28378**  
IN NAME OF

**JULIUS L. BENHAM**

Surveyed May 20, 1966, by L. E. Gould