


T.26 S. R.7 W. W.M. .

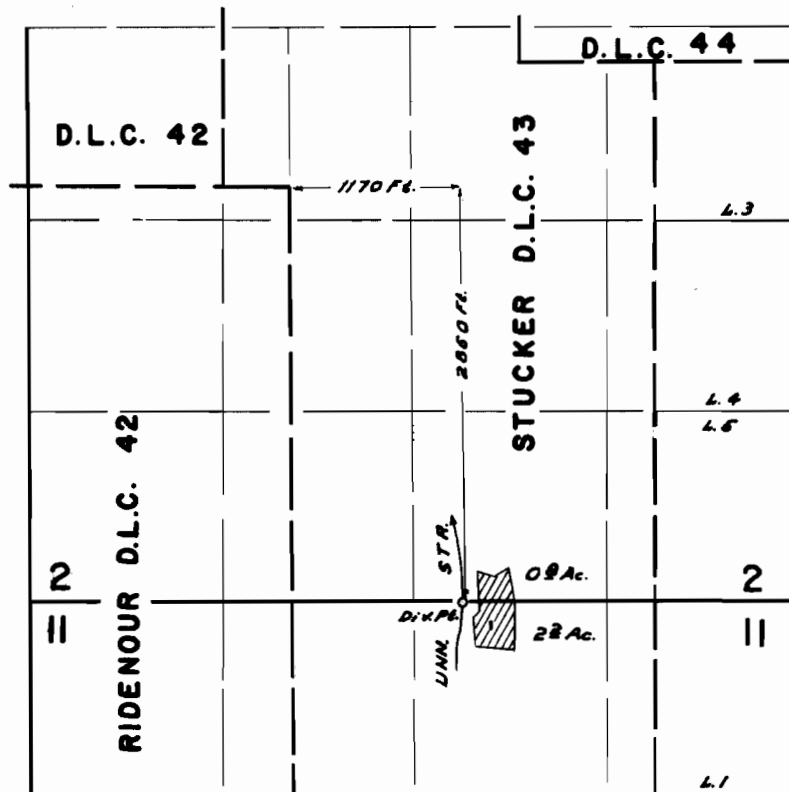

FINAL PROOF SURVEY
UNDER

Application No. 34750.. Permit No. 27280..
IN NAME OF

RAYMOND C. BENTZEN

Surveyed AUG. 10. 1965, by L. COLEBANK