


T.26&27S.R.6W.W.M.

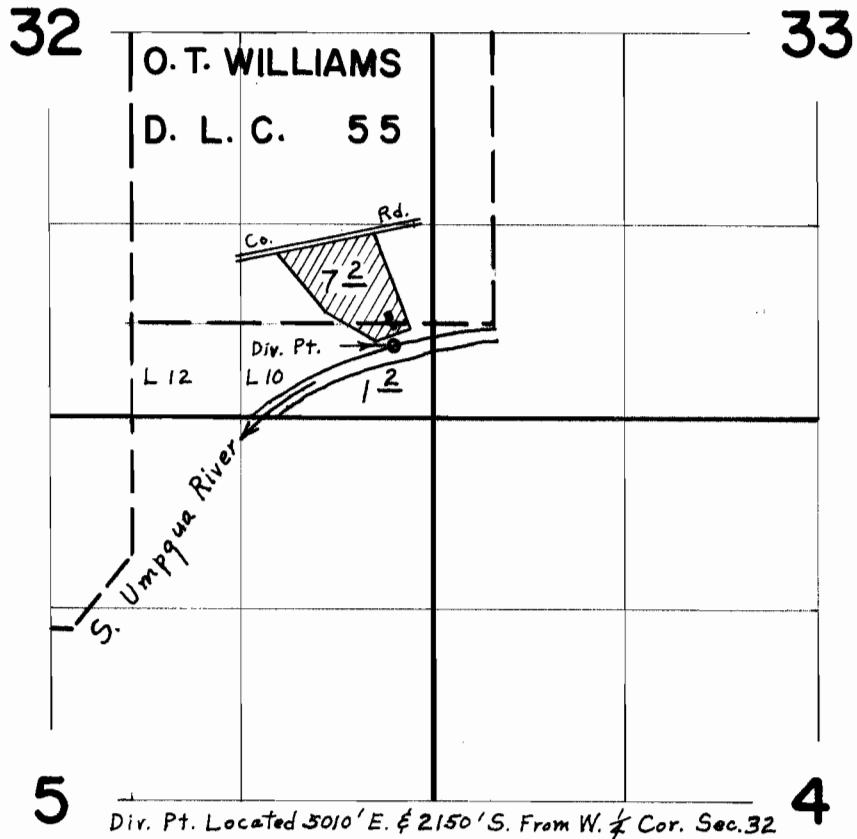

**FINAL PROOF SURVEY**  
UNDER

Application No. 39579 Permit No. 29416  
IN NAME OF

**FLOSSIE A. & HYLUS G. REYNOLDS**

Surveyed May 19, 1966, by L. E. Gould